4658509003

IREDELL COUNTY HEALTH DEPARTMENT

STATESVILLE 704-878-5305 MOORESVILLE 704-664-5281

IMPROVEMENT PERMIT / CERTIFICATE OF COMPLETION / OPERATION PERMIT / EXISTING SYSTEM INSPECTION

PROPERTY DESCRIPTION NO. 2631 DATE 4/19/94 TAX MAP NO. IM16B 26 Watershed: ☑ Yes ☐ No

OWNER OR CONTRACTOR Broadmoor Homes PHONE: Business 663-7660 Home

ADDRESS PO Box 1242 Mooresville NC.

LOCATION Rinehart Rd from 150 TL on Ketchie tr. TR on Sunshine Dr. TL on Sun Lane - cul de sac on ®

SUBDIVISION Sunshine Estates BLOCK / SECTION LOT 26 LOT AREA ~1.14Ac SITE CLASS. P DESIGN FLOW 360 L.T.A.R. .12-.25

Septic Tank: 1000 Gallons; STB Date

Pump Tank: Gallons; PT Date

Pump Make: Model Serial No.

Nitrification Field: No Fields 1 Square Feet 1440 Linear Feet 480

No Lines 6 Trench Width 3' Max Trench Bottom Depth 28" Gravel Depth 12"

☑ New System ☐ Repair System Type: I, (II), III, IV, V, VI

System Description: CONV - DROP BOXES

Repair System Description: GRAVITY PANEL 16"

Maintenance Agreement Required: ☐ Yes ☑ No

☑ House/Mod. Home No. Bedrooms 3

☐ Mobile Home No. Bathrooms 2.5

☐ Business No. Employees

☐ Other


☐ Slab ☑ Crawl Space ☐ Basement w/plumbing ☐ Basement wo/plumbing

Water Supply: ☑ Individual ☐ Community ☐ Public

Comments: Keep trenches shallow - 28" maximum depth. Plumbing must be shallow from house - Lines need to follow slope contour - BEWARE OF WELL ON LOT TO (L)

Comments:

INITIAL SITE SKETCH 231'

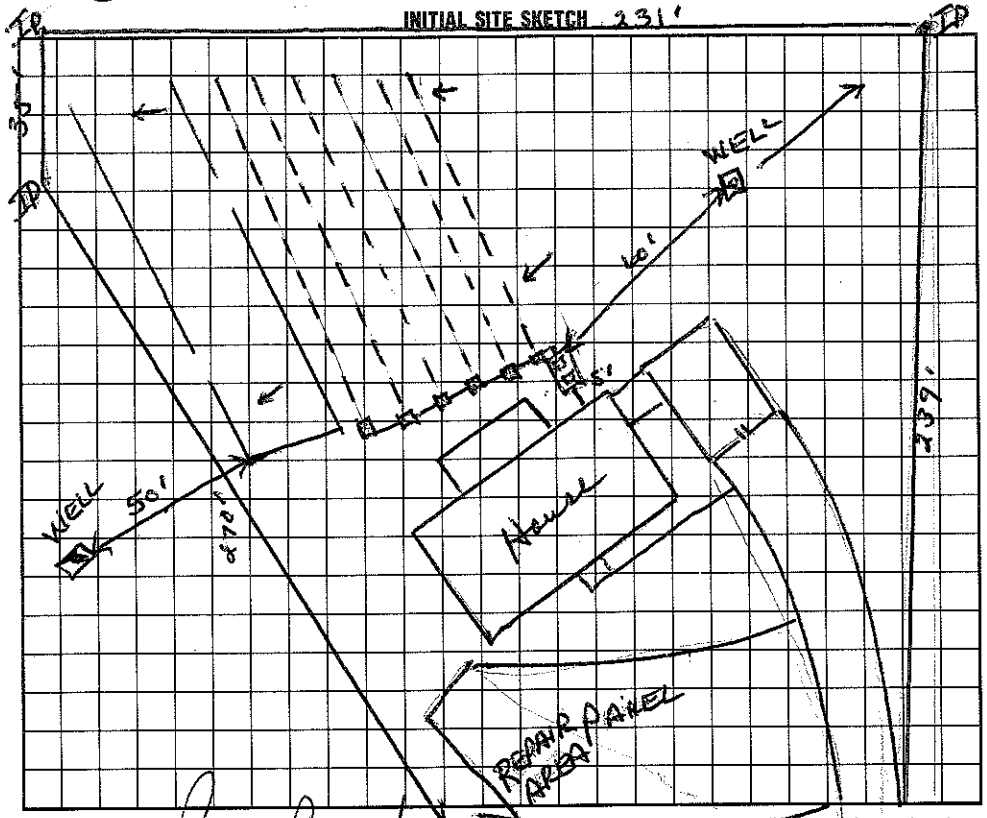

AS BUILT SKETCH

I understand that this permit can be suspended or revoked if any false information is supplied toward securing the permit/any unauthorized changes are made to the site/any unauthorized changes are made in the installation of the system. Improvement Permit is valid for 60 months from date of issuance.

Signed:

Improvement Permit by: Wesley Sparks R.S. date 4/19/94

Existing System Inspection by: date

Installed by:

Certificate of Completion by: date

Operation Permit by: date

HEALTH DEPT. COPY: WHITE INSPECTION COPY (FINAL): GREEN OWNER COPY (FINAL): YELLOW INSPECTION COPY (INITIAL): PINK OWNER COPY (INITIAL): GOLD