IREDELL COUNTY HEALTH DEPARTMENT

STATESVILLE 704-878-5305 MOORESVILLE 704-664-

IMPROVEMENT PERMIT / CERTIFICATE OF COMPLETION / OPERATION PERMIT / EXISTING SYSTEM IN

PROPERTY DESCRIPTION NO. 1846 DATE 5/18/94 TAX MAP NO. 1M 9A Pcl 14 Watershed:

OWNER OR CONTRACTOR Kenneth Carrington PHONE: Business Home 663-2343

ADDRESS 165 Lamar Dr. Mooresville, NC. 28115

LOCATION 21N FROM 15 (R) AT LAURA CHURCH, END OF ROAD, (R) ON GRAVEL FIRST (L) TO TRAILER

SUBDIVISION N/A BLOCK / SECTION LOT LOT AREA SITE CLASS. DESIGN FLOW L.T.A.R.

Septic Tank: 1000 Gallons; STB 825 Date 4/14/94
Pump Tank: Gallons; PT Date
Pump Make: Model Serial No.
Nitrification Field: No. Fields 1 Square Feet 1200 Linear Feet 400
No. Lines (7) or 8 Trench Width 3' Max Trench Bottom Depth 32" Gravel Depth 12"

☑ New System ☐ Repair System Type: I, II, III, IV, V, VI
System Description: CONV - DROP BOXES
Repair System Description: SAME
Maintenance Agreement Required: ☐ Yes ☐ No


☑ House/Mod. Home No. Bedrooms 3
☐ Mobile Home No. Bathrooms 2
☐ Business No. Employees
☐ Other
☐ Slab ☐ Crawl Space ☐ Basement w/plumbing ☐ Basement wo/plumbing

Water Supply:
☑ Individual
☐ Community
☐ Public
(FARMERS)


Comments: Very tight for space - Care must be used with construction of drainfield - Contours must be followed closely

Comments: Installed as shown

INITIAL SITE SKETCH

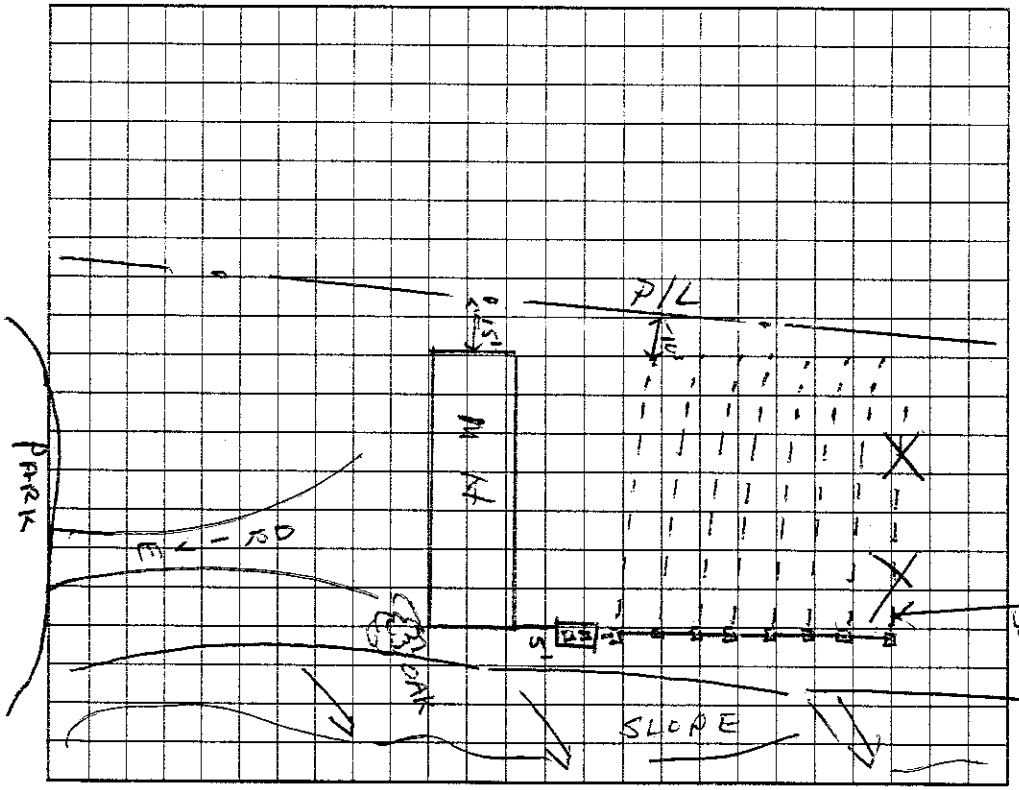

AS BUILT SKETCH

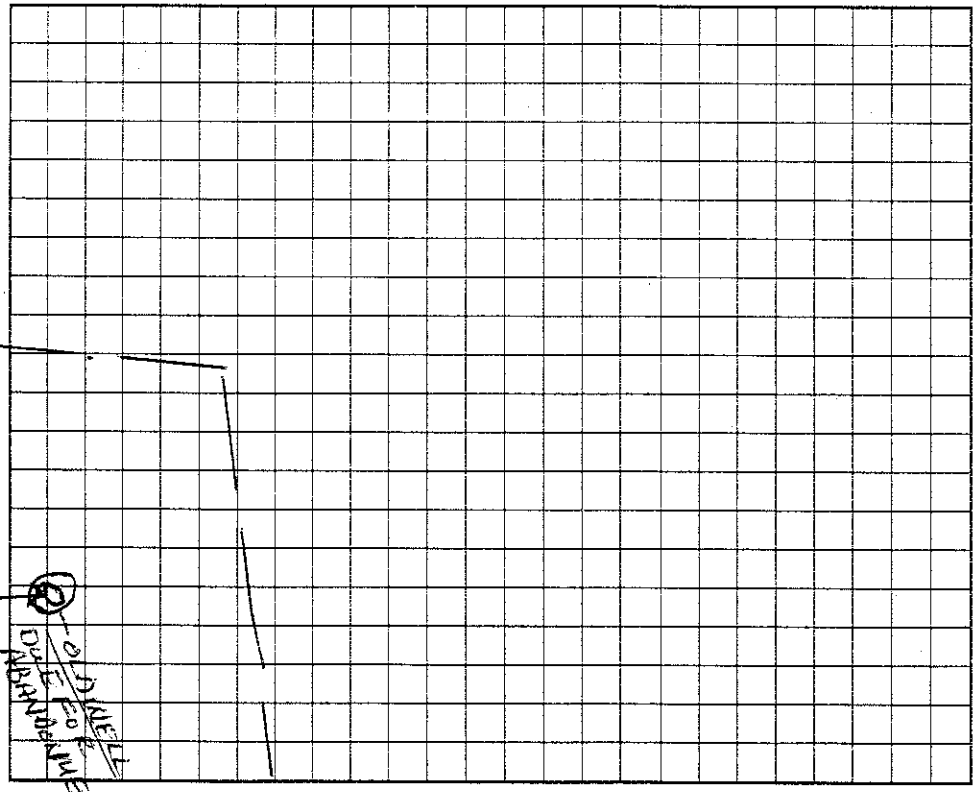

I understand that this permit can be suspended or revoked if any false information is supplied toward securing the permit/any unauthorized changes are made to the site/any unauthorized changes are made in the installation of the system. Improvement Permit is valid for 60 months from date of issuance.

Signed: Kenneth W. Carrington

Improvement Permit by: Wesley Sparks RS date 5/18/94

Existing System Inspection by: date

Installed by: Rowan Septic Tank

Certificate of Completion by: Wesley Sparks date 7/1/94

Operation Permit by: date

HEALTH DEPT. COPY: WHITE INSPECTION COPY (FINAL): GREEN OWNER COPY (FINAL): YELLOW INSPECTION COPY (INITIAL): PINK OWNER COPY (INITIAL): GOLD