IREDELL COUNTY HEALTH DEPARTMENT

→ Authorization to Construct

4658530838

STATESVILLE 704-878-5305 MOORESVILLE 704-664-5281

IMPROVEMENT PERMIT / ~~CERTIFICATE OF COMPLETION~~ / OPERATION PERMIT / EXISTING SYSTEM INSPECTION

PROPERTY DESCRIPTION NO. 23417 Repair DATE 4/16/96 TAX MAP NO. 1L-1-A-20 Watershed: ☑ Yes ☐ No

OWNER OR CONTRACTOR Jean Corrison PHONE: Business _____ Home 664-1592

ADDRESS 117 Cornelius Rd Mooresville NC 28115

LOCATION 21 - TL Cornelius Rd - 2nd House on left.

SUBDIVISION _____ BLOCK / SECTION _____ LOT _____ LOT AREA _____ SITE CLASS. _____ DESIGN FLOW _____ L.T.A.R. _____

Septic Tank: 1000 Existing Gallons; STB _____ Date _____

Pump Tank: _____ Gallons; PT _____ Date _____

Pump Make: _____ Model _____ Serial No. _____

Nitrification Field: No Fields 1 Square Feet 1000 Linear Feet 150

No Lines 3 Trench Width 20 Ft Max Trench Bottom Depth 36" Gravel Depth 24"

☐ New System ☑ Repair System Type: I (II) III. IV. V. VI

System Description: Gravity Bed System

Repair System Description: _____

Maintenance Agreement Required: ☐ Yes ☑ No

☑ House/Mod. Home No. Bedrooms 2

☐ Mobile Home No. Bathrooms 2

☐ Business No. Employees _____

☐ Other _____


☐ Slab ☑ Crawl Space ☐ Basement w/plumbing ☐ Basement wo/plumbing

Water Supply: ☑ Individual ☐ Community ☐ Public


Comments: Should be installed on contour. Stay 10' from any property line; 50' away from any well

Comments:

INITIAL SITE SKETCH

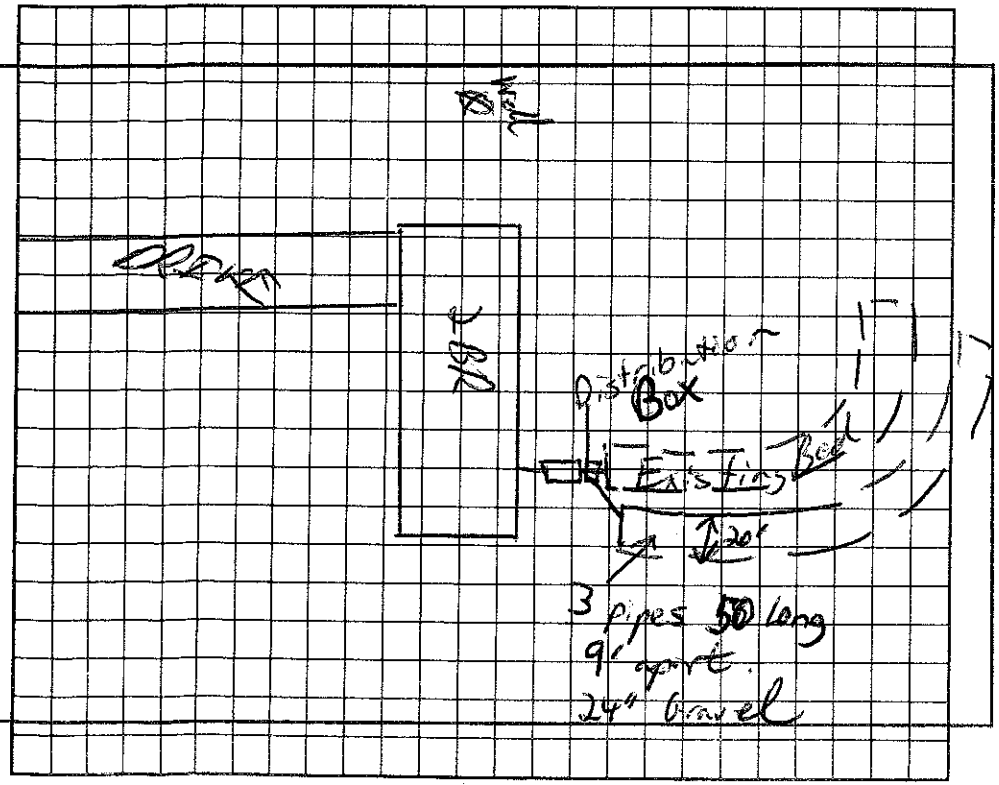

AS BUILT SKETCH

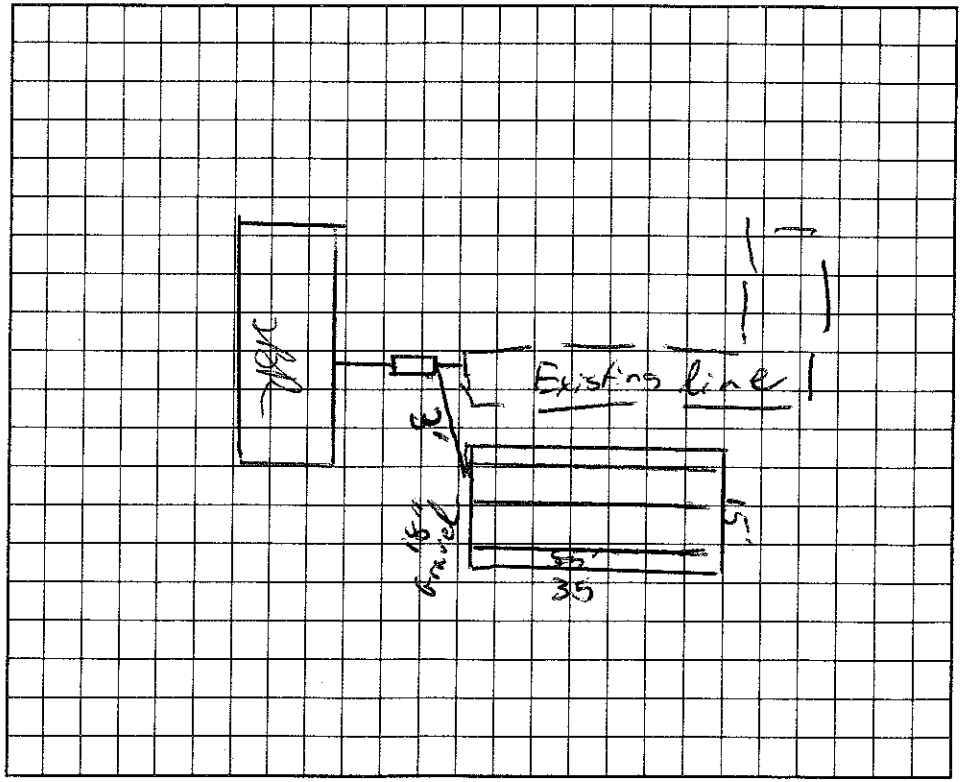

I understand that this permit can be suspended or revoked if any false information is supplied toward securing the permit/any unauthorized changes are made to the site/any unauthorized changes are made in the installation of the system.

Signed: Albert Brinson

Improvement Permit by: C. Bobby Freeman EHS date 4/16/96

Existing System Inspection by: C. Bobby Freeman EHS date 4/16/96

Installed by: Joe Thompson

Certificate of Completion by: _____ date _____

Operation Permit by: C. Bobby Freeman EHS date 5/10/96

HEALTH DEPT. COPY: WHITE INSPECTION COPY (FINAL): GREEN OWNER COPY (FINAL): YELLOW INSPECTION COPY (INITIAL): PINK OWNER COPY (INITIAL): GOLD