COPY

IREDELL COUNTY HEALTH DEPARTMENT

STATESVILLE 704-878-5305 MOORESVILLE 704-664-5281

IMPROVEMENT PERMIT / AUTHORIZATION TO CONSTRUCT / OPERATION PERMIT / EXISTING SYSTEM INSPECTION

PERMIT # 164358 PIN # 4658-53-3676 DATE 1-13-10

OWNER or APPLICANT CICERO SULLIVAN PHONE: Business 704-660-5528 Home:

OWNER or APPLICANT ADDRESS 338 SHEPHERD RD MOORESVILLE NC 28115

LOCATION / DIRECTIONS 2179 CHARLOTTE HWY

SUBDIVISION BLOCK / SECTION LOT # LOT AREA .66 AC DESIGN FLOW 384 GPD L.T.A.R. .25

Septic Tank 1000 Gallons: STB 760 Date 726

Pump Tank Gallons: P T Date

Pump Make Model Serial #

Nitrification Field No Fields 1 No Lines 6 Linear Feet 258'

Trench Width 24" Max. Trench Bottom Depth 36" Gravel Depth 16" SAND

☒ New System ☐ Repair ☐ Expansion System Type I II (III) IV V VI

System Description: PANEL BLOCK

Repair System Description: SAME

Maintenance Agreement Required ☐ YES ☐ NO

☒ GRAVITY ☐ PRESSURE

☐ Residence No. Bedrooms

☒ Business No. Persons

☐ Other No. Employees 4

☐ Slab ☐ Crawl Space


☐ Basement w/plumbing ☐ Basement w/o plumbing

Water Supply: ☐ Private ☐ Public ☐ Community

Comments / Conditions ① OLD TANK TO BE REMOVED & SUITABLE SOIL PUT IN HOLE ② MIN 5' TO FOUNDATION ③ NO PARKING ON SEPTIC AREAS ④ NO FOOD SERVICE

Comments / Conditions DESIGN FLOW = 120 GPD PER 1000 SQFT RETAIL AREA / 120 X 3.2 = 384

INITIAL SITE SKETCH

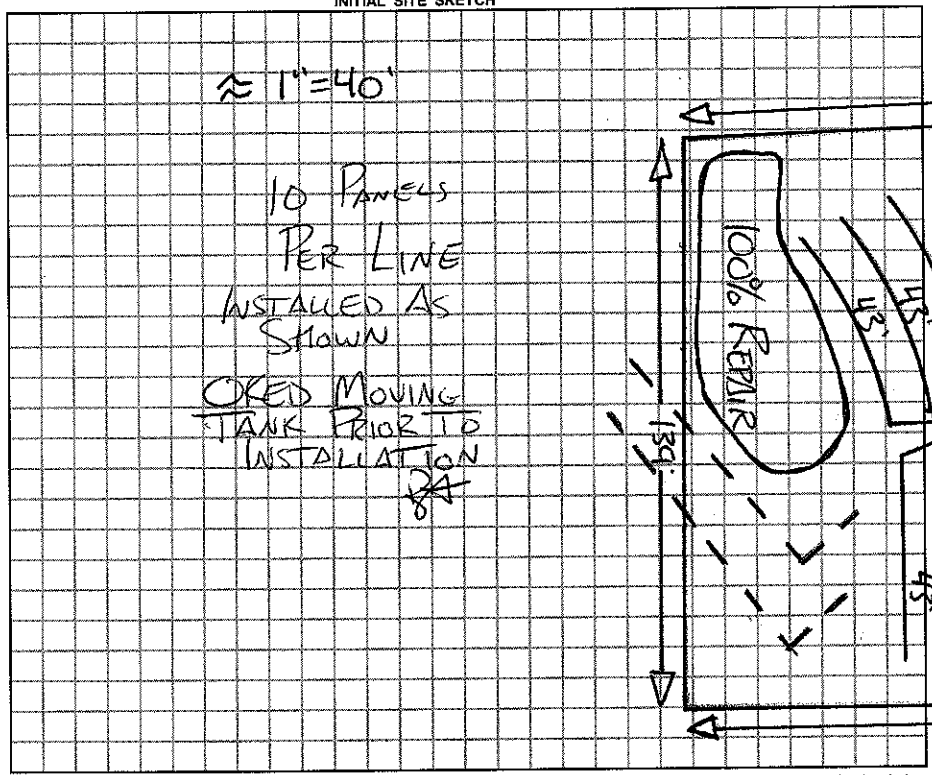

AS BUILT SKETCH

Permit can be suspended or revoked if any false information is supplied toward securing the permit / any unauthorized changes are made to the site / any unauthorized changes are made in the installation of the system.

☐ *IMPROVEMENT PERMIT w / plat valid without expiration.* ☒ *IMPROVEMENT PERMIT w / site plan valid for 60 mos.* ☐ *AUTHORIZATION TO CONSTRUCT valid for period equal to IMPROVEMENT PERMIT-not to exceed 60 mo.*

Owner / Applicant Signature: Cicero Sullivan Date 1-19-11

Improvement Permit by: R. A. Lee REHS Date 1-19-11

Authorization to Construct by: R. A. Lee REHS Date 1-19-11

YOU SHOULD CONTACT A LOCATOR SERVICE PRIOR TO ANY EXCAVATION.

Installed by: A-1 Backhoe

Operation Permit by: R. A. Lee REHS Date: 2-2-11

Existing System Inspected by: Date:

WHITE COPY Environmental Health YELLOW COPY (Final) Owner / Applicant PINK COPY (Initial) Owner / Applicant