IREDELL COUNTY HEALTH DEPARTMENT

Statesville Office (704) 878-5305 Mooresville Office (704) 660-3625 PERMIT # 210926

IMPROVEMENT PERMIT / AUTHORIZATION TO CONSTRUCT / OPERATION PERMIT / EXISTING SYSTEM

PIN # 4658-53-5107.105

APPLICANT: BOYCE KNOX APPLICANT ADDRESS: 364 INGRAM RD STATESVILLE

SITE ADDRESS: 105 BROWN RIDGE LN PHONE: 704-682-1559 ALT. PHONE:

SITE DIRECTIONS: 21N, TR BROWN RIDGE, ON L

SUBDIVISION: SECTION: LOT # LOT AREA: 2.79 AC DESIGN FLOW: 240 L.T.A.R.: .275 (.3R)

Septic Tank 1000 (gal) STB 760 Date 7-14
Pump Tank (gal) PT Date
Pump Make Model Serial #
Nitrification Fields 1 # Lines 5@44' Linear Ft: 220'
Trench Width 36" Max. Trench Bottom Depth 36" Gravel Depth —


☒ New System ☐ Repair ☐ Expansion System Type: I II III IV V VI
System Description: 25% REDUCTION
Repair System Description: PM - 25%
Maintenance Agreement Required: ☐ YES ☒ NO
☒ GRAVITY ☐ PRESSURE

☒ Residence ☐ Business ☐ Other ☐ Slab ☒ Crawl Space ☐ Basement w/plumbing ☐ Basement w/o plumbing
No. Bedrooms 2 No. Persons No. Employees


Water Supply: ☒ Private SHARED ☐ Public ☐ Community

Comments / Conditions:

INITIAL SITE SKETCH

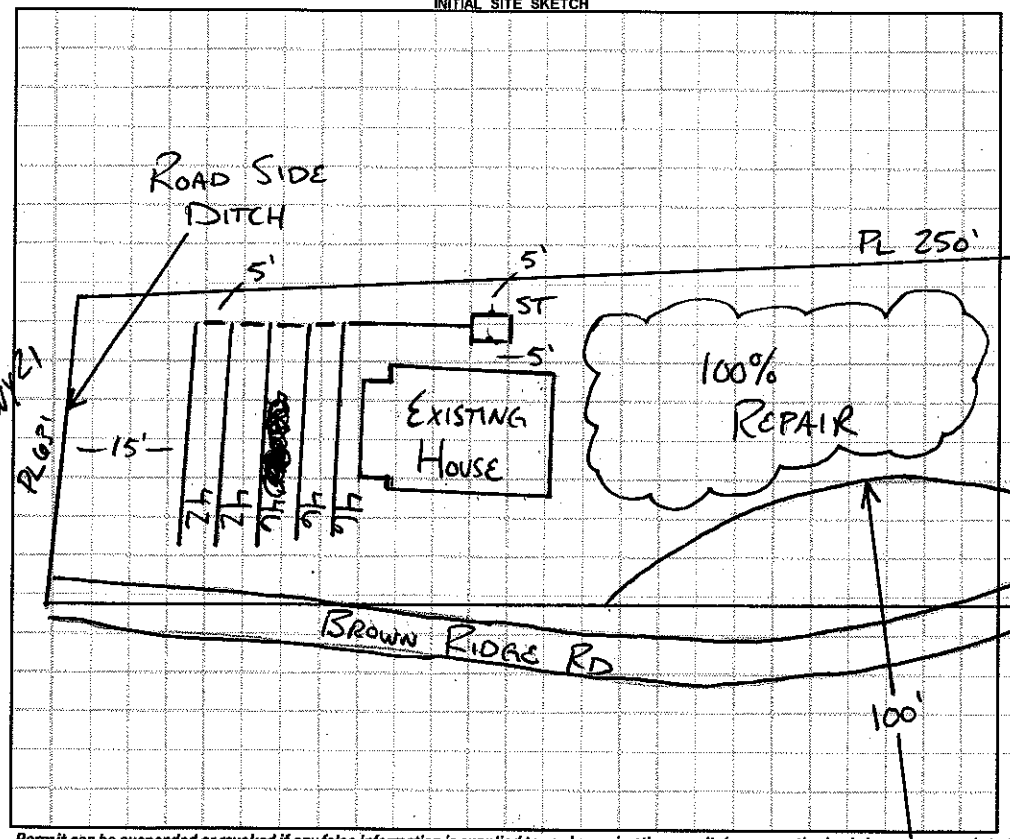

AS BUILT SKETCH

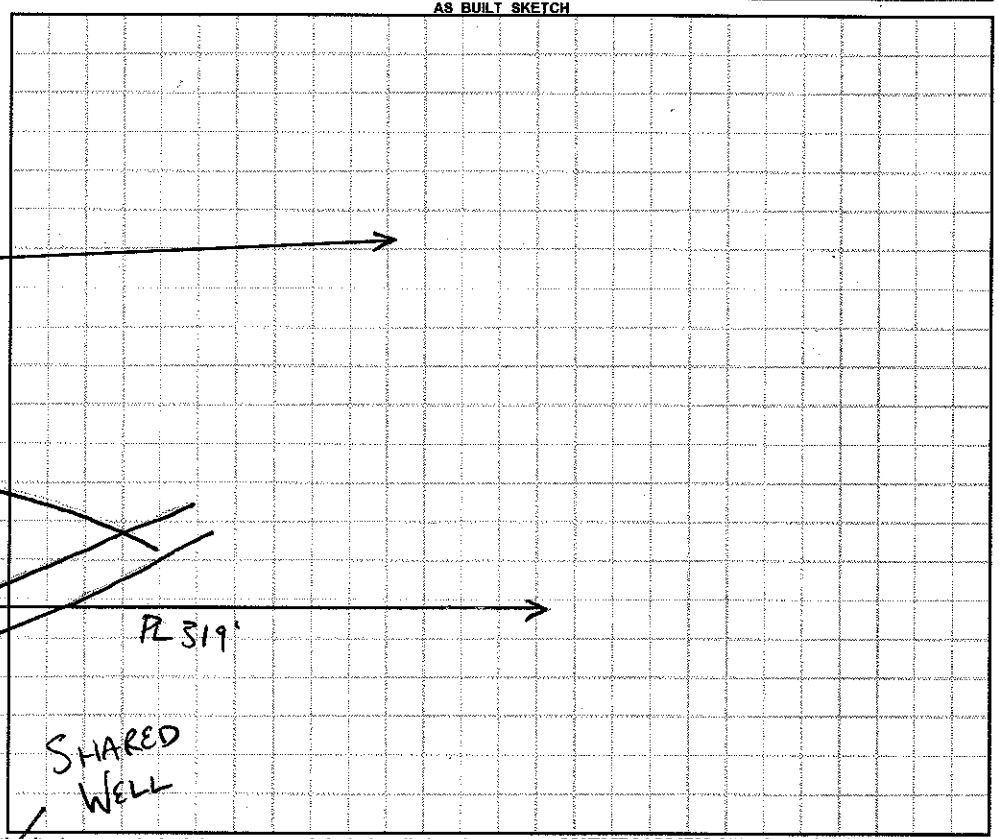

Permit can be suspended or revoked if any false information is supplied toward securing the permit / any unauthorized changes are made to the site / any unauthorized changes are made in the installation of the system. **CONTACT A LOCATOR SERVICE PRIOR TO ANY EXCAVATION**

☐ **IMPROVEMENT PERMIT** *with plat valid without expiration.* ☒ **IMPROVEMENT PERMIT** *with site plan valid for 60 mos.* ☐ **AUTHORIZATION TO CONSTRUCT** *valid for period equal to IMPROVEMENT PERMIT--not to exceed 60 mo.*

Owner / Applicant Signature: Date: 9-10-15 Installed by: GROUND BREAKERS

IMPROVEMENT PERMIT by: APPROVED SEP 10 2015 Date:

AUTHORIZATION TO CONSTRUCT by: APPROVED SEP 16 2015 Date:

OPERATION PERMIT by: Date: 11-5-15

Existing System Inspected by: Date:

Health Dept. Copy - WHITE Applicant (Final Approval) - YELLOW Applicant (Conditional Approval) - PINK