IREDELL COUNTY HEALTH DEPARTMENT

Statesville Office (704) 878-5305 Mooresville Office (704) 660-3625 PERMIT # 21358

IMPROVEMENT PERMIT / AUTHORIZATION TO CONSTRUCT / OPERATION PERMIT / EXISTING SYSTEM

PIN # 4658-53-5107.122

APPLICANT: Boyce Knox APPLICANT ADDRESS:

SITE ADDRESS: 122 Brown Ridge Ln. PHONE: 704-682-1559 ALT. PHONE:

SITE DIRECTIONS: 21N, TR Brown Ridge Ln.

SUBDIVISION: — SECTION: — LOT # — LOT AREA: 2.79AC DESIGN FLOW: 360 L.T.A.R.: .35

Septic Tank EXISTING (gal) STB Date

Pump Tank (gal) PT Date

Pump Make Model Serial #

Nitrification Fields 1 # Lines 4 Linear Ft: 257'

Trench Width 36" Max. Trench Bottom Depth 32" Gravel Depth —

☐ New System ☒ Repair ☐ Expansion System Type: I II (III) IV V VI

System Description:

Repair System Description: 25% REDUCTION

Maintenance Agreement Required: ☐ YES ☒ NO

☒ GRAVITY ☐ PRESSURE

☒ Residence ☐ Business ☐ Other ☐ Slab ☐ Basement w/plumbing


No. Bedrooms 3 No. Persons No. Employees

☒ Crawl Space ☐ Basement w/o plumbing


Water Supply: ☒ Private ☐ Public ☐ Community

Comments / Conditions: 260 INSTALLED

INITIAL SITE SKETCH

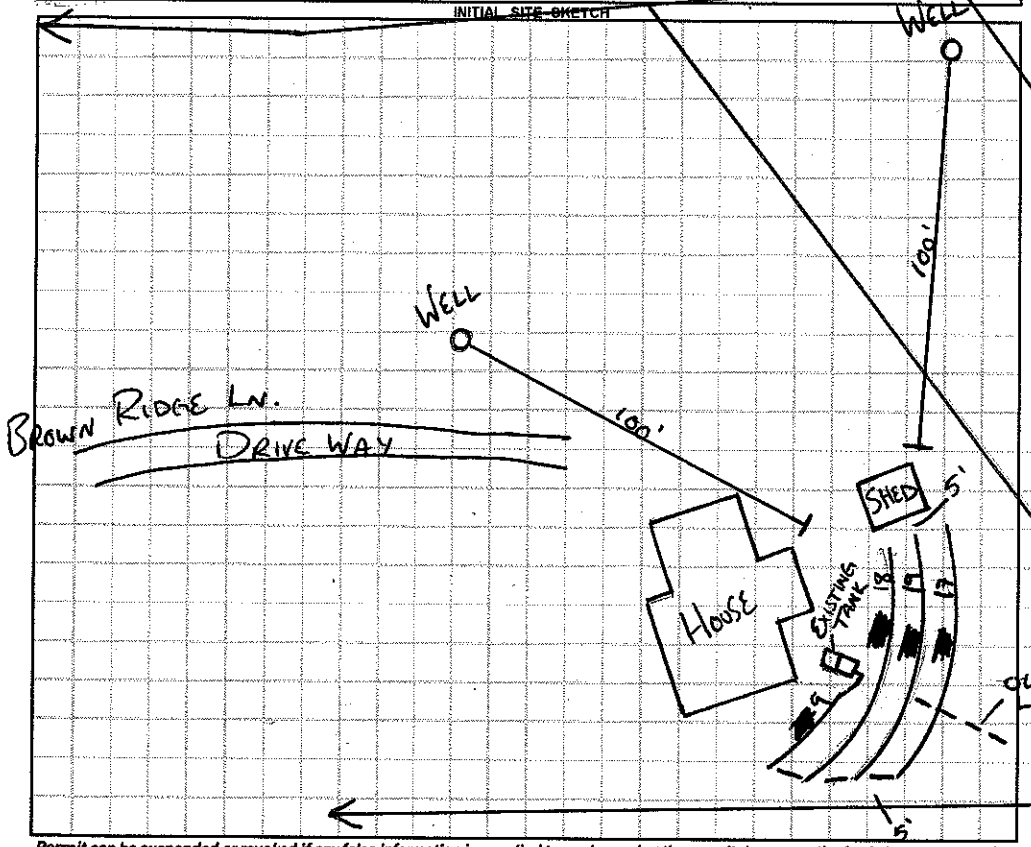

AS-BUILT SKETCH

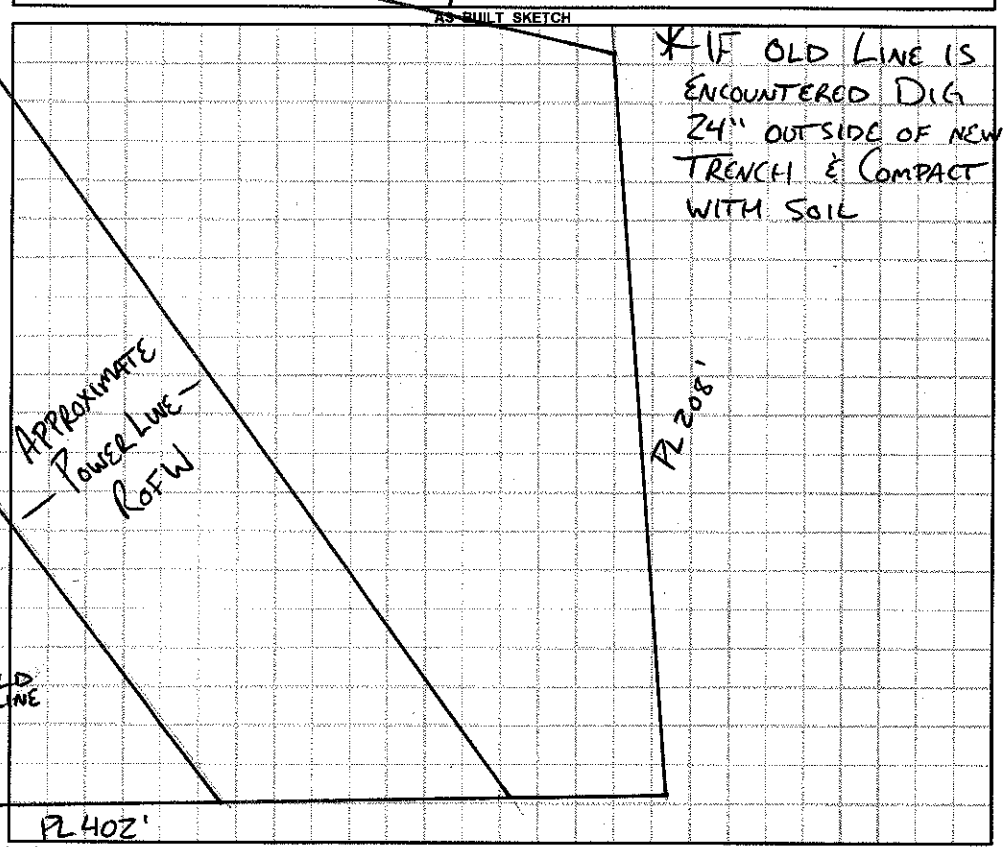

Permit can be suspended or revoked if any false information is supplied toward securing the permit / any unauthorized changes are made to the site / any unauthorized changes are made in the installation of the system. **CONTACT A LOCATOR SERVICE PRIOR TO ANY EXCAVATION**

☐ **IMPROVEMENT PERMIT** *with plat valid without expiration.* ☐ **IMPROVEMENT PERMIT** *with site plan valid for 60 mos.* ☒ **AUTHORIZATION TO CONSTRUCT** *valid for period equal to IMPROVEMENT PERMIT--not to exceed 60 mo.*

Owner / Applicant Signature: Date: 9-10-15 Installed by: GROUND BREAKERS

IMPROVEMENT PERMIT by: APPROVED Date: SEP 02 2015 OPERATION PERMIT by: Date: 11-6-15

AUTHORIZATION TO CONSTRUCT by: APPROVED Date: SEP 02 2015 Existing System Inspected by: Date:

Health Dept. Copy - WHITE Applicant (Final Approval) - YELLOW Applicant (Conditional Approval) - PINK