10347

4658547950

IREDELL COUNTY HEALTH DEPARTMENT

(SEPTIC TANK) IMPROVEMENTS PERMIT AND CERTIFICATE OF COMPLETION
(Ground Absorption Sewage Disposal System -- G. S. Chapter 130-Article 13C)

OWNER OR CONTRACTOR Laney's Fish Camp DATE 8/15/89 PERMIT NO. IM-A-73-A

PHONE: Business _____ Home _____

LOCATION Hwy 21 North On left before 1307 (Bailey Rd)

S. R. No. _____

SUBDIVISION NAME _____ LOT NO. _____ SECTION OR BLOCK NO. _____

House ( ) Mobile Home ( ) Business (✓) Other Kitchen enlargement

No. Bedrooms _____ No. Bathrooms 2


Garbage Disposal Unit	Yes ( )	No ( )	
Auto. Dishwasher	Yes ( )	No ( )	
Auto. Wash. Machine	Yes ( )	No ( )	
Site Suitable	Yes ( )	No ( )	

Character & Porosity of Soil existing system
Percolation Rate
Topography
Depth to Water Table
Rock or other impervious formations

System for can wash and 2 baths.

Lot Area _____

_____ Basement with Plumbing _____ Basement without Plumbing _____ No Basement New Grease Trap.

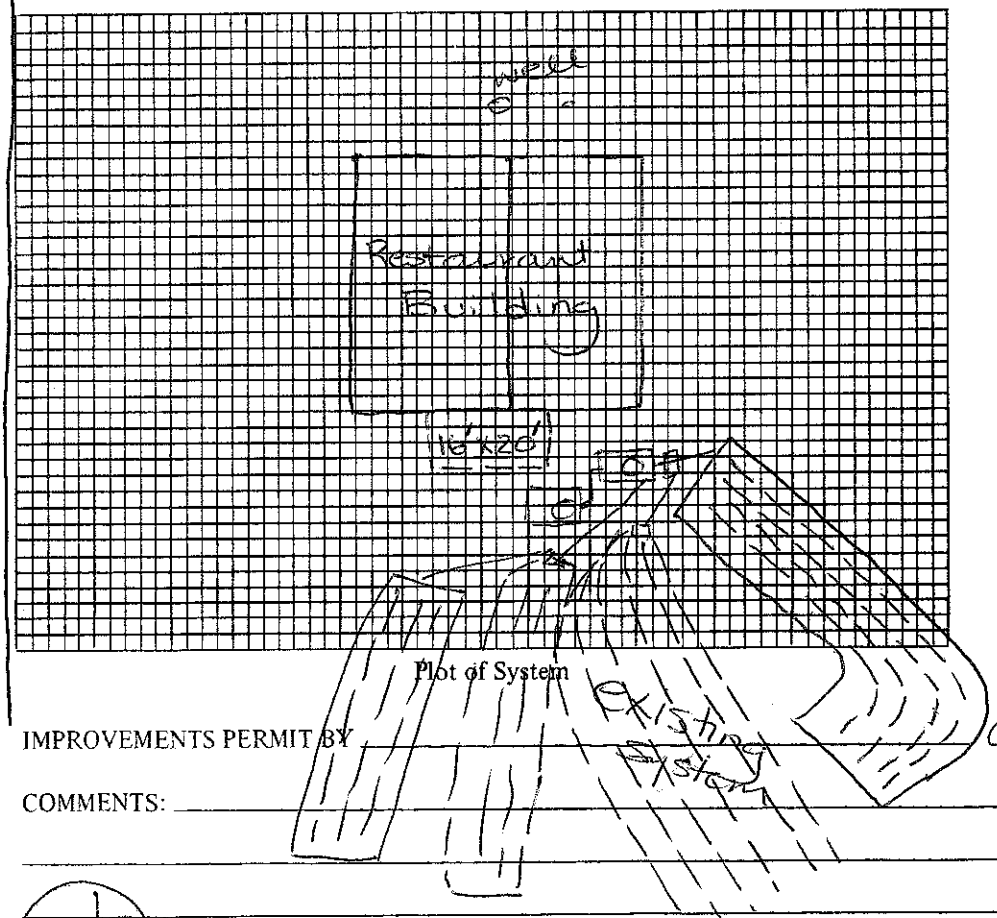

Plot of System

Size of Tank existing Gals.

Nitrification Field:
No. of Lines existing
Sq. Ft. _____ Linear Ft. _____
Depth of Stone in Lines existing

Water Supply: Individual (✓)
Public ( )

Installed by Julian Bowles

I understand and agree to install septic tank system as specified on this Improvements Permit.

Signed: _____

IMPROVEMENTS PERMIT BY Andre C. Pierce, R. S.

COMMENTS: Replace grease tank 5'± off structure.

* Tank Replacement ONLY

CERTIFICATE OF COMPLETION BY Andre C. Pierce DATE _____

EXISTING SYSTEM CHECKED BY: This tank (pump) was installed properly DATE 8/25/89

CONSTRUCTION MUST COMPLY WITH ALL OTHER APPLICABLE STATE AND LOCAL REGULATIONS.

Permit is VOID if any unauthorized changes are made in installation of system and/or if any false information is supplied in making Improvements Permit.

Health Dept. Copy: White Inspection Dept. Copy: Yellow Sanitarian's Copy: Pink Owner's Copy: Gold