IREDELL COUNTY HEALTH DEPARTMENT

STATESVILLE 704-878-5305 MOORESVILLE 704-664-5281

IMPROVEMENT PERMIT / AUTHORIZATION TO CONSTRUCT / OPERATION PERMIT / EXISTING SYSTEM INSPECTION

PERMIT# 09 2153 PIN# ~~4658-56-4039 Pt.~~ 4658-56-4217 DATE 10/26/00

OWNER OR CONTRACTOR Thomas Jones PHONE: Business _____ Home 892-0159

ADDRESS 19406 Meridan St. Cornelius NC 28031

LOCATION Hwy 21N TL Baily Rd. TL at #167 to end of drive

SUBDIVISION GREEN MEADOW BLOCK / SECTION _____ LOT 1 LOT AREA ± 1.26 SITE CLASS. PS DESIGN FLOW 360 L.T.A.R. .3

Septic Tank: 1000 Gallons; STB 312 Date 5/15/00
Pump Tank: _____ Gallons; PT _____ Date _____
Pump Make: _____ Model _____ Serial No. _____
Nitrification Field: No Fields 1 Square Feet 900 Linear Feet 348
No Lines 5 Trench Width 3' Max Trench Bottom Depth 3' Gravel Depth SAND.

☒ New System ☐ Repair System Type: I, II, III, IV, V, VI
System Description: New - CH. PLASTIC
Repair System Description: 16" PPBS
Maintenance Agreement Required: ☐ Yes ☒ No

☒ House/Mod. Home No. Bedrooms 4
☐ Mobile Home No. Bathrooms 2
☐ Business No. Employees _____
☐ Other _____
☐ Slab ☒ Crawl Space ☐ Basement w/plumbing ☐ Basement wo/plumbing


Water Supply:
☒ Individual
☐ Public
☐ Community

Comments:/Conditions:

Comments:/Conditions:

INITIAL SITE SKETCH

AS BUILT SKETCH (1" = 50')

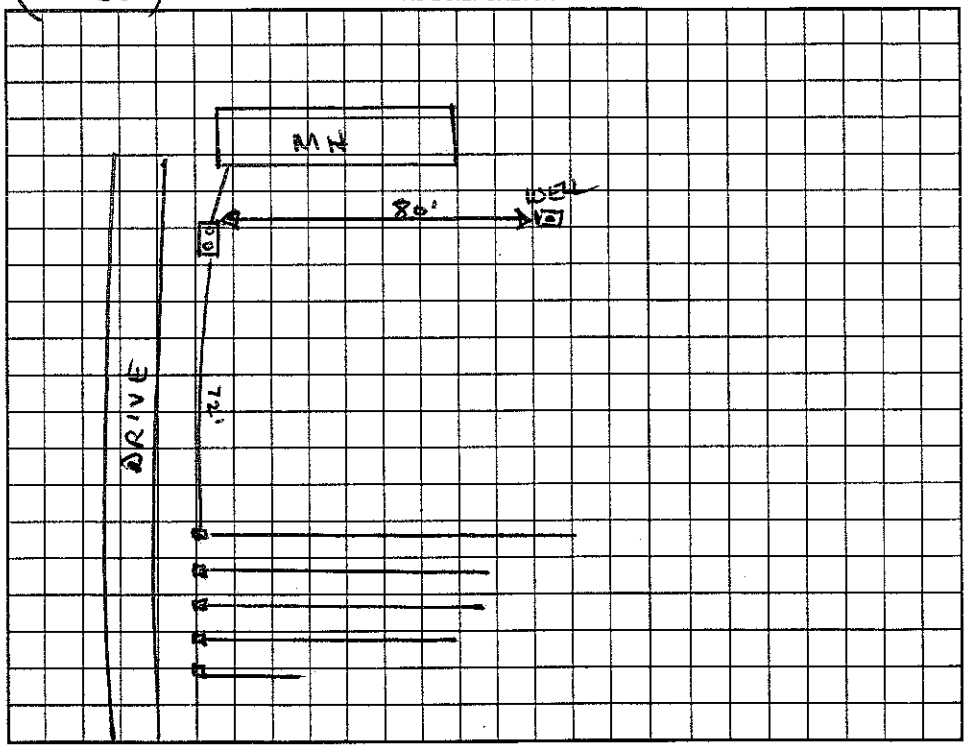

Permit can be suspended or revoked if any false information is supplied toward securing the permit/any unauthorized changes are made to the site/any unauthorized changes are made in the installation of the system. Improvement Permit with plat valid without expiration. Improvement Permit with site plan valid for sixty months. Authorization to Construct is valid for a period equal to that of Improvement Permit – not to exceed sixty months.

Signed: _____ date _____

Improvement Permit by: _____ date _____

Authorization to Construct by: _____ date _____

Installed by: Larry Beam.

Operation Permit by: Wesley Sparks RS. date 10/26/00

Existing System Inspection by: _____ date _____

HEALTH DEPT. COPY: WHITE OWNER COPY (FINAL): YELLOW OWNER COPY (INITIAL): PINK

IREDELL COUNTY HEALTH DEPARTMENT

S...esville 704-878-5305 — D — MOORESVILLE 704-664-5281

IMPROVEMENT PERMIT / AUTHORIZATION TO CONSTRUCT / OPERATION PERMIT / EXISTING SYSTEM INSPECTION

PERMIT# 092153 PIN# 4658564039 PT DATE 10/6/2000

OWNER OR CONTRACTOR Thomas Jones PHONE: Business Home 892-0159

ADDRESS 19406 Meridan St. Cornelius NC 28031

LOCATION Hwy 21 N TL Bailey Rd TL at 167 Bailey Rd take gravel drive behind to end

SUBDIVISION Green Meadows BLOCK / SECTION LOT 1 LOT AREA 1.26 Acre SITE CLASS. PS DESIGN FLOW 450 gpd L.T.A.R. .35 (Initial)

Septic Tank: 1000 Gallons; STB 312 Date 5/15/00

Pump Tank: Gallons; PT Date

Pump Make: Model Serial No. 348

Nitrification Field: No Fields 1 Square Feet 1358' Linear Feet ~~950~~ 343

No Lines ~~5 @ 90'~~ Trench Width 36" Max Trench Bottom Depth ~~36~~ 34" Gravel Depth 12"

☒ New System ☐ Repair System Type: I, II, III, IV, V, VI

System Description: ~~Gravity Conventional~~

Repair System Description: ~~Gravity~~ Innovative

Maintenance Agreement Required: ☐ Yes ☒ No

☐ House/Mod. Home No. Bedrooms 4

☒ Mobile Home No. Bathrooms 2

☐ Business No. Employees

☐ Other

☐ Slab ☒ Crawl Space ☐ Basement w/plumbing ☐ Basement wo/plumbing


Water Supply: ☒ Individual ☐ Public ☐ Community

Comments:/Conditions: Keep Septic at least 10' from PL, 5' from house & 50' from well. Must stay 15' from any slope/bank > 2'


Comments:/Conditions: 5 lines - 100, 75, 75, 68, 25 (343) Ch. Plastic installed

CH. PLASTIC (MH)

INITIAL SITE SKETCH Not to Scale

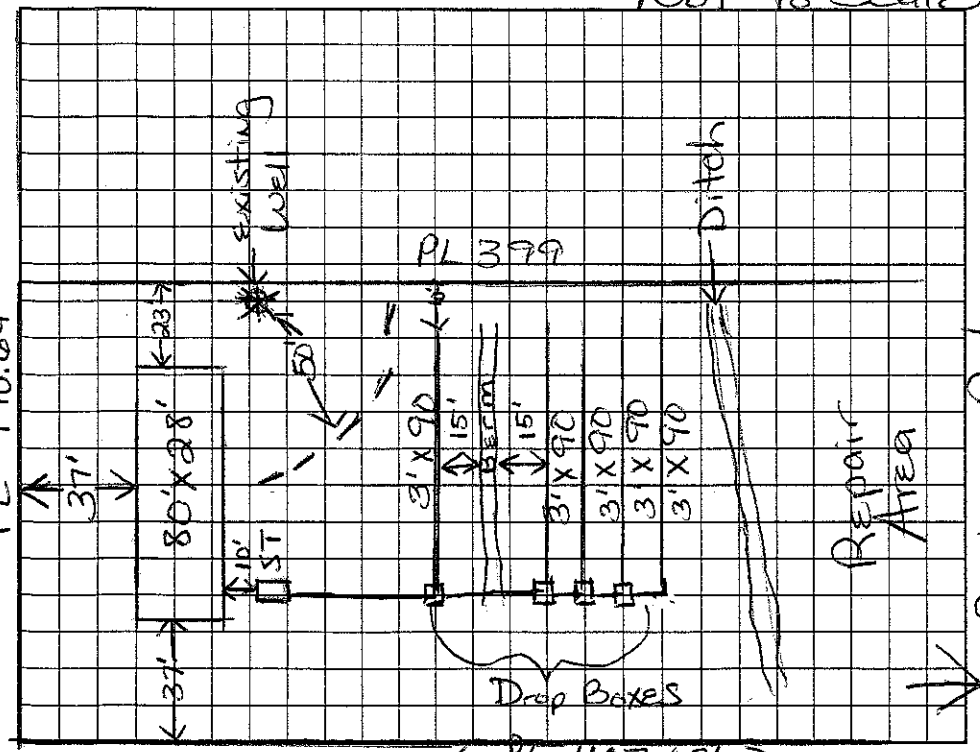

AS BUILT SKETCH

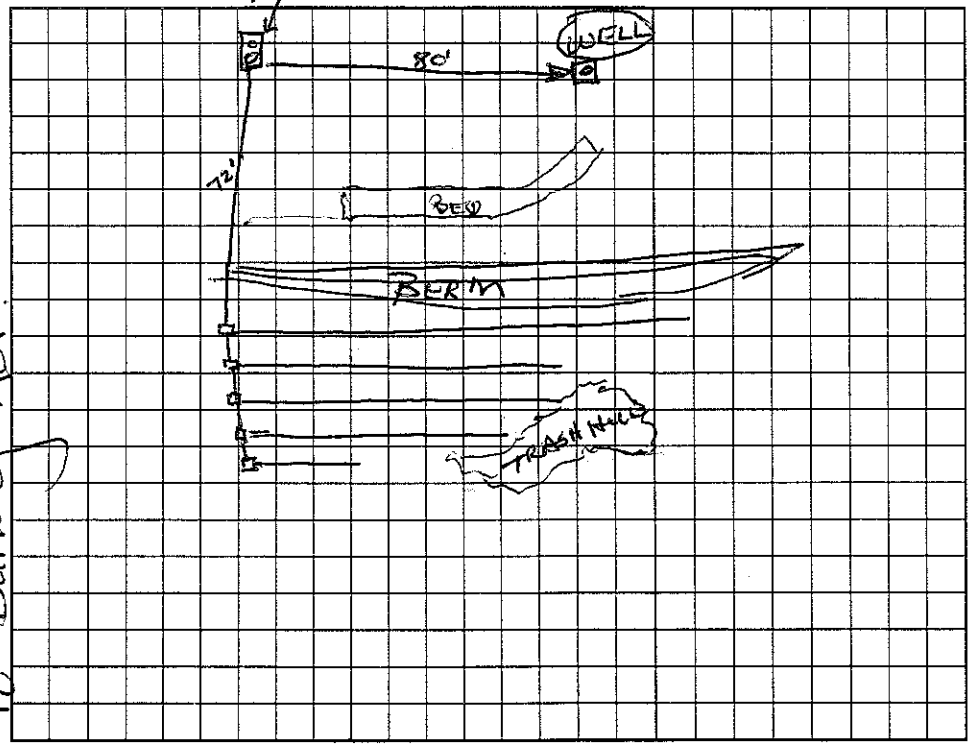

Permit can be suspended or revoked if any false information is supplied toward securing the permit/any unauthorized changes are made to the site/any unauthorized changes are made in the installation of the system. Improvement Permit with plat valid without expiration. Improvement Permit with site plan valid for sixty months. Authorization to Construct is valid for a period equal to that of Improvement Permit – not to exceed sixty months.

Signed: Larry Jones date 10 9 00 Installed by: Larry Beam

Improvement Permit by: [signature] date 10/6/2000 Operation Permit by: Wesley Sparks RS date 10/25/00

Authorization to Construct by: [signature] date 10/6/2000 Existing System Inspection by: date

HEALTH DEPT. COPY: WHITE OWNER COPY (FINAL): YELLOW OWNER COPY (INITIAL): PINK