IREDELL COUNTY HEALTH DEPARTMENT

4658568457

STATESVILLE 704-878-5305 | MOORESVILLE 704-664-5281

11:30

IMPROVEMENT PERMIT / CERTIFICATE OF COMPLETION / OPERATION PERMIT / EXISTING SYSTEM INSPECTION

PROPERTY DESCRIPTION NO. 067863 DATE 7/22/97 TAX MAP NO. 4658569369 Watershed: ☐ Yes ☒ No

OWNER OR CONTRACTOR Brian Overcash PHONE: Business 664-3113 Home 663-0282

ADDRESS 144 Bailey Rd

LOCATION 21N to Bailey Rd Rt 4th place on right

SUBDIVISION _____ BLOCK/ SECTION _____ LOT _____ LOT AREA 1 Acre SITE CLASS. P.S. DESIGN FLOW 360 gpd L.T.A.R. .3

Septic Tank: 1000 Gallons; STB 744 Date 5/26/97

Pump Tank: _____ Gallons; PT _____ Date _____

Pump Make: _____ Model _____ Serial No. _____

Nitrification Field: No Fields 1 Square Feet 1200 Linear Feet 400

No Lines 4 at 100' Trench Width 36 Max Trench Bottom Depth 36" Gravel Depth 12"

☐ New System ☐ Repair System Type: I, II, III, IV, V, VI

System Description: Gravity Conventional

Repair System Description: Pump-Conv.

Maintenance Agreement Required: ☐ Yes ☒ No

☒ House/Mod. Home No. Bedrooms 3

☐ Mobile Home No. Bathrooms 2

☐ Business No. Employees _____

☐ Other _____


☐ Slab ☒ Crawl Space ☐ Basement w/plumbing ☐ Basement wo/plumbing

Water Supply: ☒ Individual Existing ☐ Community ☐ Public


Comments: Keep Tanks lines 18' from house. Existing System installed 12/94 will be abandoned

Comments: HOUSE DID NOT IN PLACE AT TIME OF INSPECTION.

INITIAL SITE SKETCH Scale 1:50

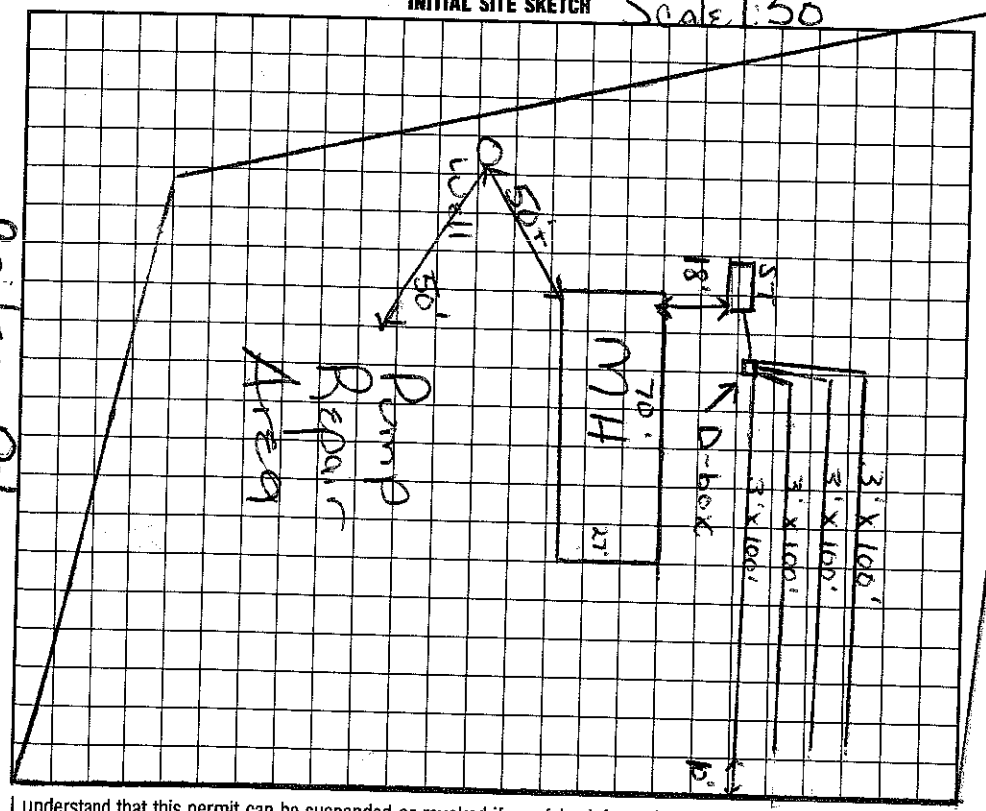

AS BUILT SKETCH

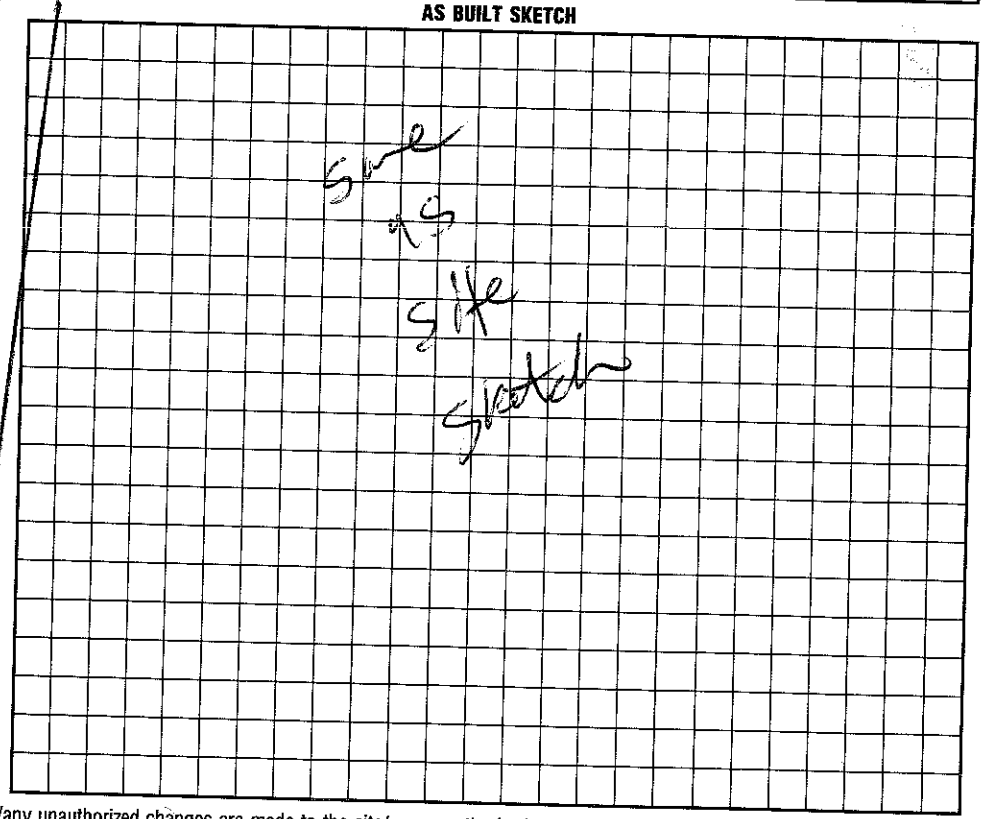

I understand that this permit can be suspended or revoked if any false information is supplied toward securing the permit/any unauthorized changes are made to the site/any unauthorized changes are made in the installation of the system. Improvement Permit is valid for 60 months from date of issuance.

Signed: X Brian Overcash

Improvement Permit by: Maria H. Dotson date 7/22/97

Existing System Inspection by: Maria H. Dotson date 7/22/97

Installed by: JOE THOMPSON

Certificate of Completion by: _____ date _____

Operation Permit by: _____ date 8/7/97

HEALTH DEPT. COPY: WHITE INSPECTION COPY (FINAL): GREEN OWNER COPY (FINAL): YELLOW INSPECTION COPY (INITIAL): PINK OWNER COPY (INITIAL): GOLD

Awaiting Construct