IREDELL COUNTY HEALTH DEPARTMENT

Paid 300.00

STATESVILLE 704-878-5305 MOORESVILLE 704-664-5281

IMPROVEMENT PERMIT / AUTHORIZATION TO CONSTRUCT / OPERATION PERMIT / EXISTING SYSTEM INSPECTION

PERMIT# 7701 PIN# 4658 60 1031 + 8272 DATE 5/16/00

OWNER OR CONTRACTOR Albert Lee PHONE: Business Home 664-7250

ADDRESS 130 Ketchie Drive Mooresville, NC. 28115

LOCATION 150 E TL Rinehart Rd TL on Sunkene on (R) before cul de sac

SUBDIVISION Sunshine Estate BLOCK / SECTION LOT 25A LOT AREA .79 AC SITE CLASS. PS DESIGN FLOW 360 L.T.A.R.

Septic Tank: 1000 Gallons; STB 1012 Date 8/14/00
Pump Tank: 1000 Gallons; PT 19 Date 12/14/99
Pump Make: GOULDS Model WEC-511H Serial No. J003116
Nitrification Field: No Fields 1 Square Feet 1080 Linear Feet 360
No Lines 3 Trench Width 36" Max Trench Bottom Depth 36" ~~Gravel Depth~~ SAND

[X] New System [ ] Repair System Type: I, II, (III) IV, V, VI
System Description: PM — CHAM PLASTIC
Repair System Description: SAME
Maintenance Agreement Required: [ ] Yes [X] No


[X] House/Mod. Home No. Bedrooms 3
[ ] Mobile Home No. Bathrooms 3
[ ] Business No. Employees
[ ] Other
[X] Slab [X] Crawl Space [ ] Basement w/plumbing [ ] Basement wo/plumbing

Water Supply: [X] Individual [ ] Public [ ] Community


Comments:/Conditions: 100' separation required between wells and Septic Systems due to Saprolite conditions.

Comments:/Conditions: 10/11/00 Tanks, Drainlines, Press. Manifold checked

INITIAL SITE SKETCH (1" = 40')

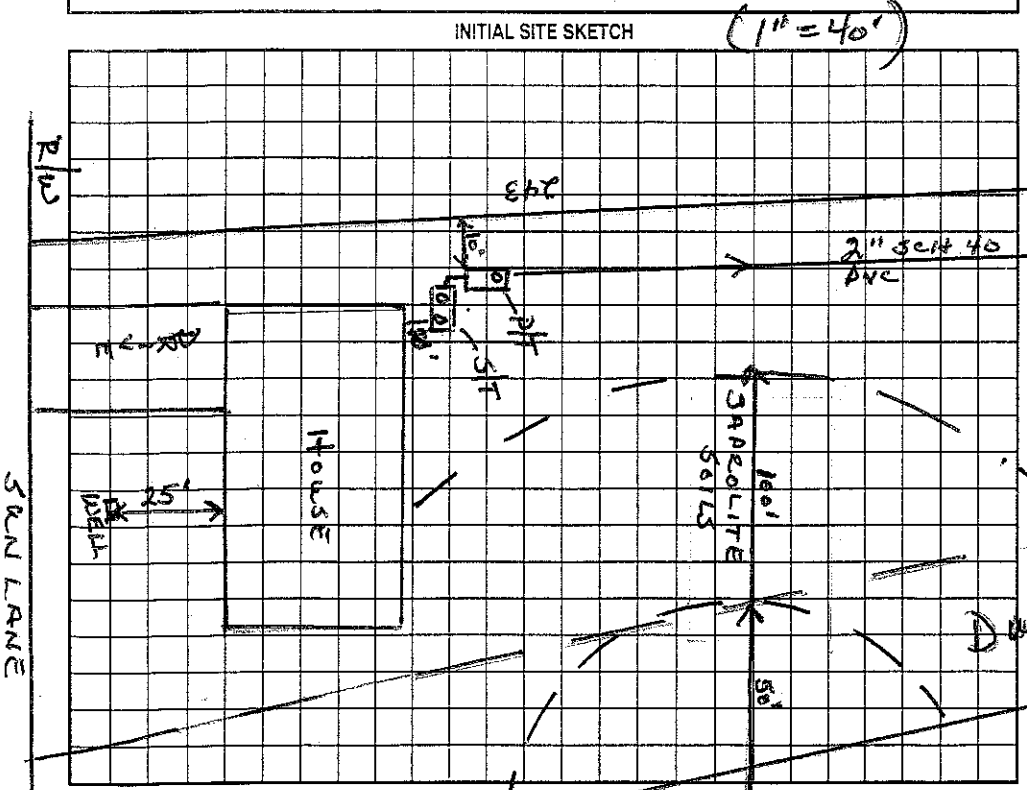

AS BUILT SKETCH

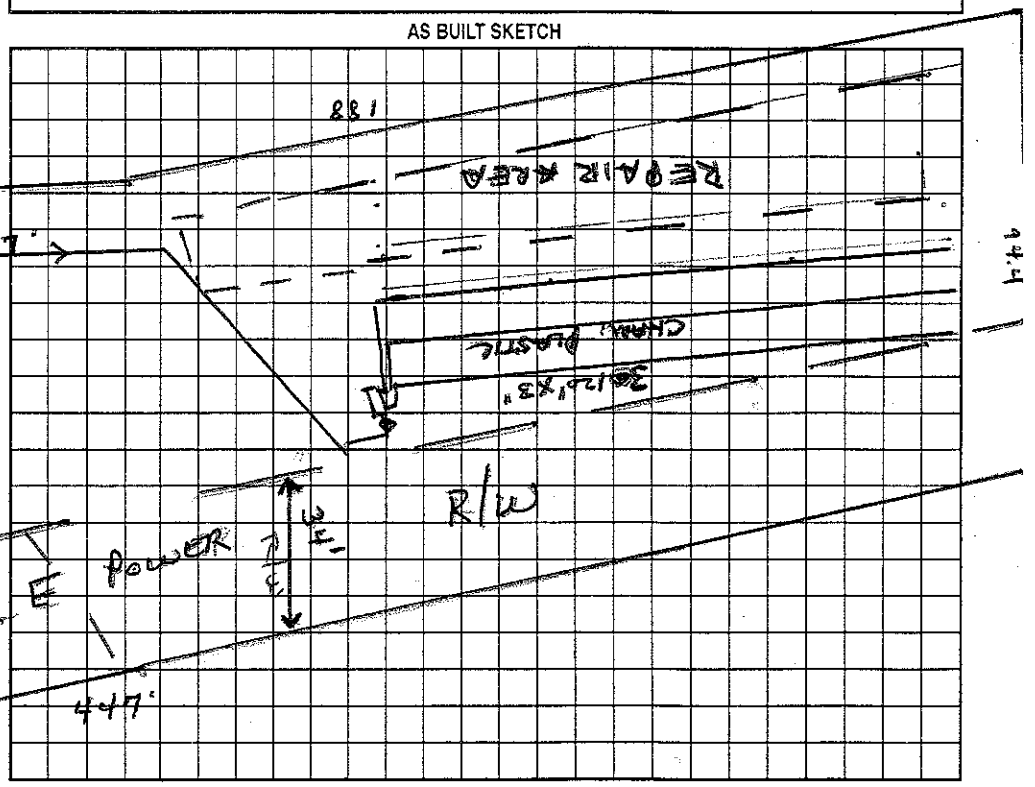

Permit can be suspended or revoked if any false information is supplied toward securing the permit/any unauthorized changes are made to the site/any unauthorized changes are made in the installation of the system. Improvement Permit with plat valid without expiration. Improvement Permit with site plan valid for sixty months. Authorization to Construct is valid for a period equal to that of Improvement Permit – not to exceed sixty months.

Signed: * Cathy Lynch date 5-16-2000 Installed by: Steve Jordan

Improvement Permit by: Wesley Sparks RSS. date 5/16/00 Operation Permit by: Wesley Sparks RS date 12/4/00

Authorization to Construct by: Wesley Sparks RS. date 5/25/00 Existing System Inspection by: date

HEALTH DEPT. COPY: WHITE OWNER COPY (FINAL): YELLOW OWNER COPY (INITIAL): PINK