IREDELL COUNTY HEALTH DEPARTMENT

STATESVILLE 704-878-5305 MOORESVILLE 704-664-5281

IMPROVEMENT PERMIT / AUTHORIZATION TO CONSTRUCT / OPERATION PERMIT / EXISTING SYSTEM INSPECTION

PERMIT# 6769 PIN# 4658603054 DATE 6/23/99

OWNER OR CONTRACTOR Curtis Welch PHONE: Business 663-1368 Home

ADDRESS 162 Sun Lane Mooresville NC 28115

LOCATION Reinhart Rd TL Sun Lane next to last house on Right

SUBDIVISION Sunshine Est. BLOCK / SECTION LOT 24 LOT AREA SITE CLASS. DESIGN FLOW L.T.A.R.

Septic Tank: 1000 Gallons; STB Existing Date System
Pump Tank: Gallons; PT Date
Pump Make: Model Serial No.
Nitrification Field: No Fields 1 Square Feet 1035 Linear Feet 345'
No Lines 4 at 86' Trench Width 36" Max Trench Bottom Depth 36" Gravel Depth 12"

☐ New System ☐ Repair System Type: I, II, III, IV, V, VI
System Description: Existing
Repair System Description:
Maintenance Agreement Required: ☐ Yes ☐ No

☒ House/Mod. Home No. Bedrooms 3
☐ Mobile Home No. Bathrooms 2
☐ Business No. Employees
☐ Other
☐ Slab ☒ Crawl Space ☐ Basement w/plumbing ☐ Basement wo/plumbing


Water Supply: ☒ Individual ☐ Public ☐ Community

Comments:/Conditions:
Addition to House does not affect setbacks of Existing Septic System.
* System originally installed 12/98. mo

Comments:/Conditions: Existing Septic System appears to be functioning okay at time of inspection, NO problems noticed.

INITIAL SITE SKETCH

AS BUILT SKETCH Not to Scale

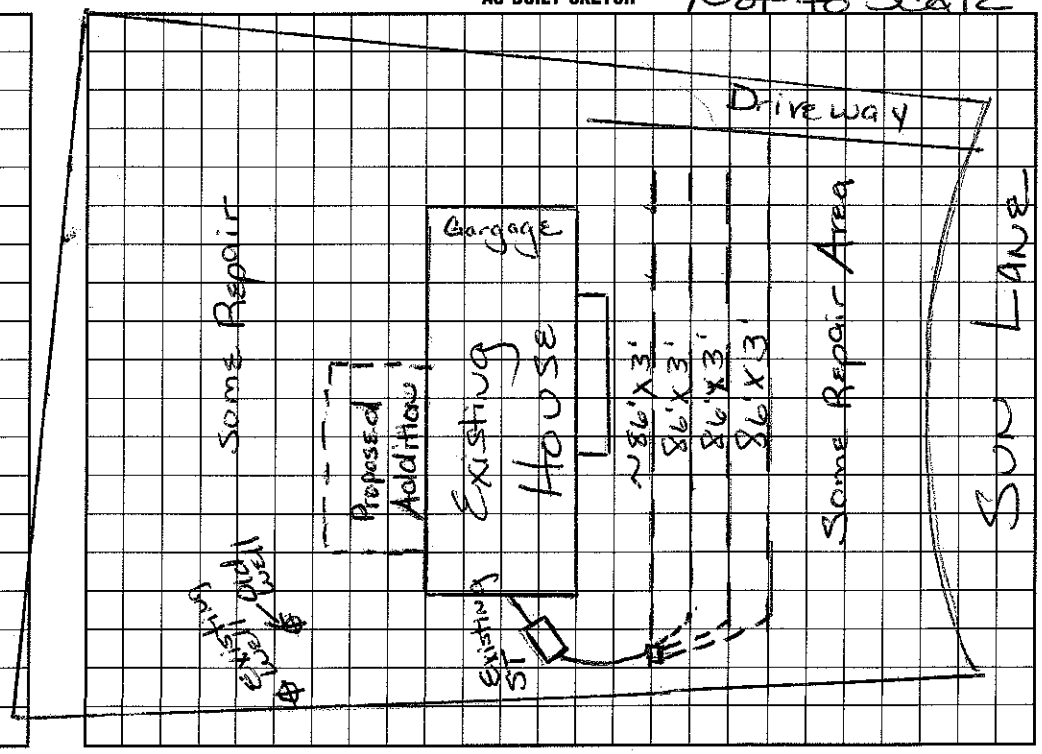

I understand that this permit can be suspended or revoked if any false information is supplied toward securing the permit/any unauthorized changes are made to the site/any unauthorized changes are made in the installation of the system. Improvement Permit with plat valid without expiration. Improvement Permit with site plan valid for sixty months. Authorization to Construct is valid for a period equal to that of Improvement Permit – not to exceed sixty months.

Signed: X Curt Welch date 6/23/99

Improvement Permit by: date

Authorization to Construct by: Maria H. Dotson RS date 6/23/99

Installed by:

Operation Permit by: Maria H. Dotson date 6/23/99

Existing System Inspection by: Maria H. Dotson date 6/23/99

HEALTH DEPT. COPY: WHITE INSPECTION COPY (FINAL): GREEN OWNER COPY (FINAL): YELLOW INSPECTION COPY (INITIAL): PINK OWNER COPY (INITIAL): GOLD