IREDELL COUNTY HEALTH DEPARTMENT

STATESVILLE 704-878-5305 MOORESVILLE 704-664-5281

IMPROVEMENT PERMIT / AUTHORIZATION TO CONSTRUCT / OPERATION PERMIT / EXISTING SYSTEM INSPECTION

PERMIT# 8503 PIN# 4658 60 5070 Lincoln DATE 2/1/01

OWNER OR CONTRACTOR Rodney + Lana McCehee - Shawn PHONE: Business Home 799-7972

ADDRESS 249 Cornelius Rd. Mooresville, NC. 28117

LOCATION Rinehardt Rd off 150 TL Sunshine to 9th lot on (R)

SUBDIVISION SUNSHINE ESTATES / SECTION LOT 23 LOT AREA 1.02 Ac SITE CLASS. RS DESIGN FLOW 360 L.T.A.R. .3

Septic Tank: 1000 Gallons; STB 1007 Date 3/4/02

Pump Tank: Gallons; PT Date

Pump Make: Model Serial No.

Nitrification Field: No Fields 1 Square Feet 1200 Linear Feet 400

No Lines 3 @ 133' Trench Width 3' Max Trench Bottom Depth 3' Gravel Depth 12"

[X] New System [ ] Repair System Type: I, II, III, IV, V, VI

System Description: GRAV - CONVENTIONAL

Repair System Description: PRESSURE - MODIFIED

Maintenance Agreement Required: [ ] Yes [X] No

[X] House [ ] Mobile Home [ ] Business [ ] Other

No. Bedrooms 3 No. Bathrooms 3 No. Employees

[ ] Slab [X] Crawl Space [ ] Basement w/plumbing [ ] Basement wo/plumbing


Water Supply: [X] Individual [ ] Public [ ] Community

Comments:/Conditions:

Comments:/Conditions:

Conventional installed

INITIAL SITE SKETCH (1"=50')

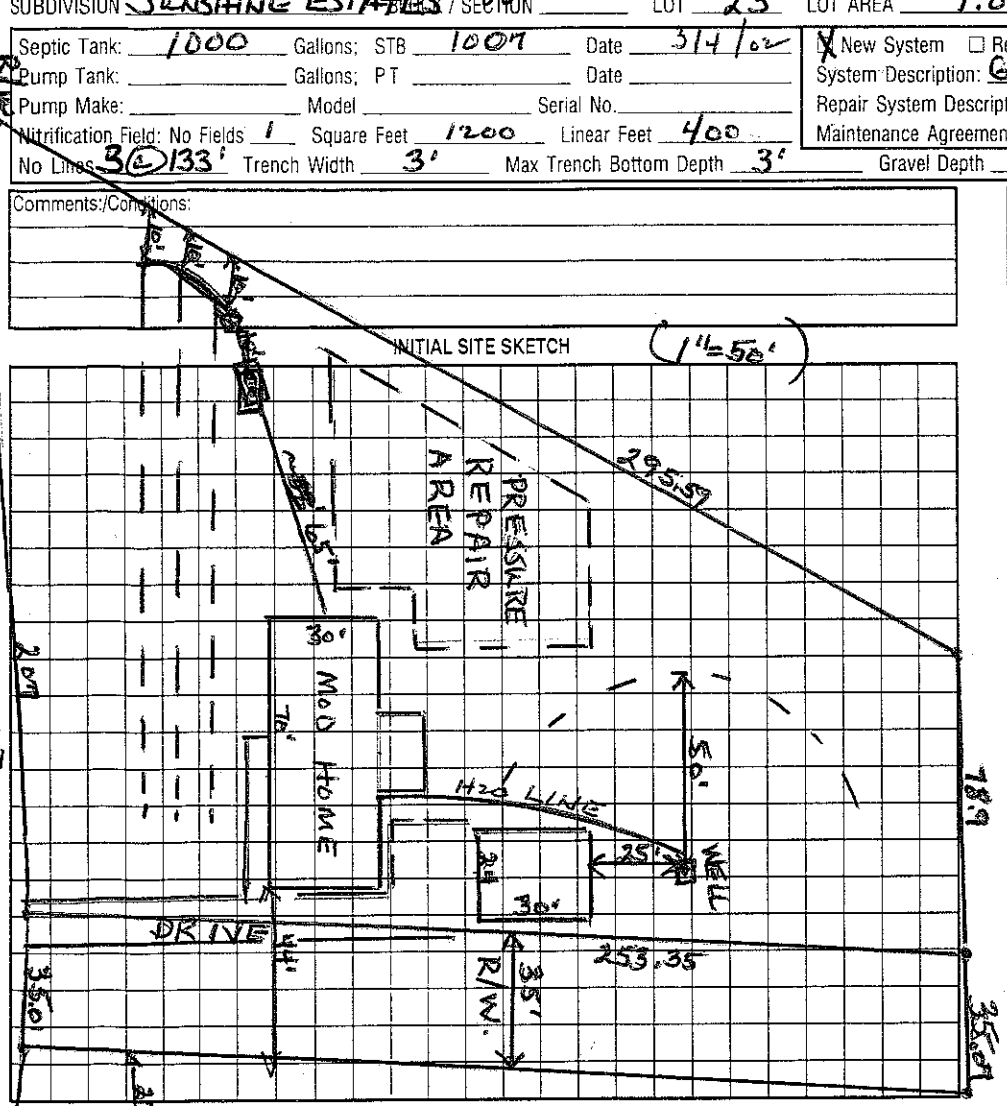

AS BUILT SKETCH

Permit can be suspended or revoked if any false information is supplied toward securing the permit/any unauthorized changes are made to the site/any unauthorized changes are made in the installation of the system. Improvement Permit with plan valid without expiration. Improvement Permit with site plan valid for sixty months. Authorization to Construct is valid for a period equal to that of Improvement Permit – not to exceed sixty months.

Signed: * Lana McCehee date 6/29/01

Improvement Permit by: Wesley Sparks RS. date 2/1/01

Authorization to Construct by: Wesley Sparks RS. date 2/1/01

Installed by: CW Grading

Operation Permit by: Wesley Sparks RS. date 5/21/02

Existing System Inspection by: date

HEALTH DEPT. COPY: WHITE OWNER COPY (FINAL): YELLOW OWNER COPY (INITIAL): PINK