IREDELL COUNTY HEALTH DEPARTMENT

STATESVILLE 704-878-5305 MOORESVILLE 704-664-5281

IMPROVEMENT PERMIT / CERTIFICATE OF COMPLETION / OPERATION PERMIT / EXISTING SYSTEM INSPECTION

PROPERTY DESCRIPTION NO. 2510 DATE 11/22/93 TAX MAP NO. IM 16A 1 Watershed: ☒ Yes ☐ No

OWNER OR CONTRACTOR BROADMOOR HOMES PHONE: Business 663-7660 Home 4658-60-6071

ADDRESS PO BOX 1242 MOORESVILLE, NC. 28115

LOCATION RINEHART RD. TL 2ND ENTRANCE TO LAST LOT ON (R)

SUBDIVISION KETCHIE ACRES BLOCK / SECTION 1 LOT 1 LOT AREA .652 SITE CLASS. P DESIGN FLOW 360 L.T.A.R. .25

Septic Tank: 1000 Gallons; STB 325 Date 3/1/94

Pump Tank: _____ Gallons; PT _____ Date _____

Pump Make: _____ Model _____ Serial No. _____

Nitrification Field: No Fields ____ Square Feet 1440 Linear Feet 480

No Lines 5 Trench Width 31 Max Trench Bottom Depth 28" Gravel Depth 12"

☒ New System ☐ Repair System Type: I, (II), III, IV, V, VI

System Description: CONV - DIST BOX

Repair System Description: _____

Maintenance Agreement Required: ☐ Yes ☒ No

☒ House/Mod. Home No. Bedrooms 3

☐ Mobile Home No. Bathrooms 2

☐ Business No. Employees ____

☐ Other _____

☐ Slab ☐ Crawl Space ☐ Basement w/plumbing ☐ Basement wo/plumbing

Water Supply: ☒ Individual ☐ Community ☐ Public


Comments:

(2) PRESSURE REPAIR AREA

Comments:

Installed as drawn

INITIAL SITE SKETCH

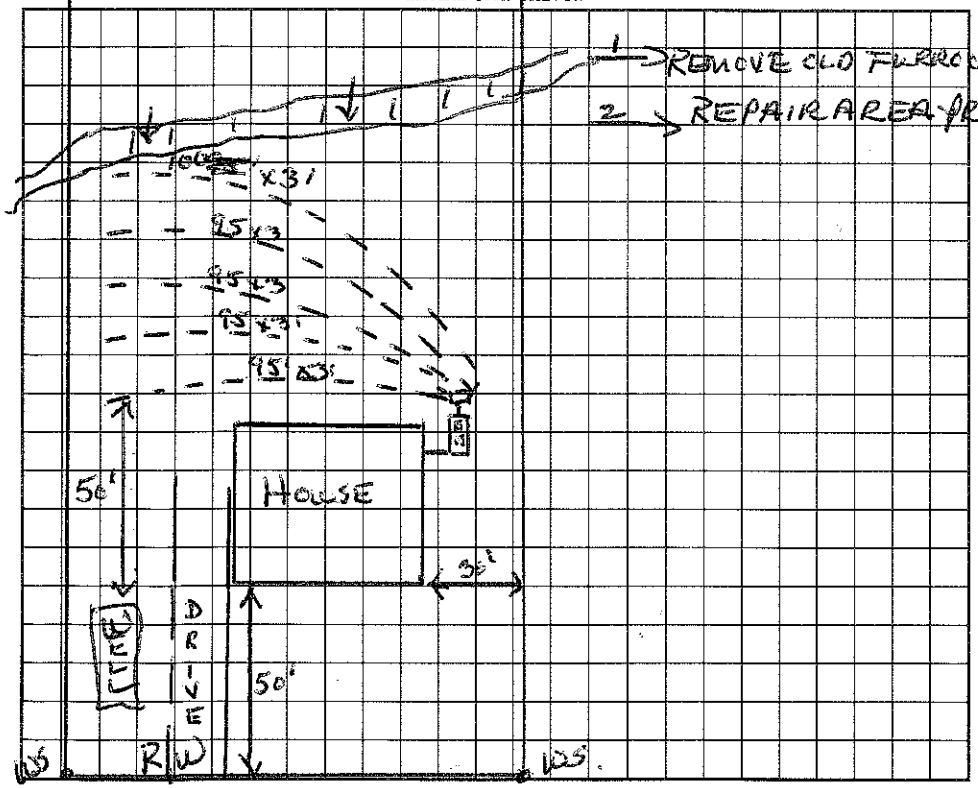

AS BUILT SKETCH

I understand that this permit can be suspended or revoked if any false information is supplied toward securing the permit/any unauthorized changes are made to the site/any unauthorized changes are made in the installation of the system. Improvement Permit is valid for 60 months from date of issuance.

Signed: Wesley A. Sparks

Improvement Permit by: Wesley Sparks R.S. date 11/22/93

Existing System Inspection by: _____ date _____

Installed by: Curt Dunning

Certificate of Completion by: Wesley Sparks R.S. date 4/22/94

Operation Permit by: _____ date _____

HEALTH DEPT. COPY: WHITE INSPECTION COPY (FINAL): GREEN OWNER COPY (FINAL): YELLOW INSPECTION COPY (INITIAL): PINK OWNER COPY (INITIAL): GOLD