Authorization to Construct

IREDELL COUNTY HEALTH DEPARTMENT

STATESVILLE 704-878-5305 MOORESVILLE 704-664-5281

IMPROVEMENT PERMIT / ~~CERTIFICATE OF COMPLETION~~ / OPERATION PERMIT / EXISTING SYSTEM INSPECTION

PROPERTY DESCRIPTION NO. 3845 DATE 10/22/96 TAX MAP NO. IMA 182 + 183 4658 60 7382 Watershed: X Yes ☐ No

OWNER OR CONTRACTOR Daniel Stevens PHONE: Business _____ Home 663-3882

ADDRESS 318 Rinehardt Rd. Mooresville, NC.

LOCATION 150 E TL Rinehart Rd. TL ideal Ln. to west to first drive on (R)

SUBDIVISION _____ BLOCK / SECTION _____ LOT N/A LOT AREA ~ 2 Ac SITE CLASS PS DESIGN FLOW 360 L.T.A.R. .3

Septic Tank: 1000 Gallons; STB 794 Date 3-3-97

Pump Tank: 1000 Gallons; PT 27 Date 2-29-97

Pump Make: Hydromatic Model SK50A1 Serial No. None

Nitrification Field: No Fields 1 Square Feet 1200 / Linear Feet 400

No Lines 3 Trench Width 36" Max Trench Bottom Depth 30" Gravel Depth 12"

X New System ☐ Repair System Type: I, II, (III), IV, V, VI

System Description: PRESMAN — CONVENTIONAL

Repair System Description: SAME

Maintenance Agreement Required: ☐ Yes X No

X House/Mod. Home ☐ Mobile Home ☐ Business ☐ Other

No. Bedrooms 3 No. Bathrooms 3 No. Employees ____


Water Supply: X Individual ☐ Community ☐ Public

☐ Slab X Crawl Space ☐ Basement w/plumbing ☐ Basement wo/plumbing


Comments:

Electrical Pending

INITIAL SITE SKETCH

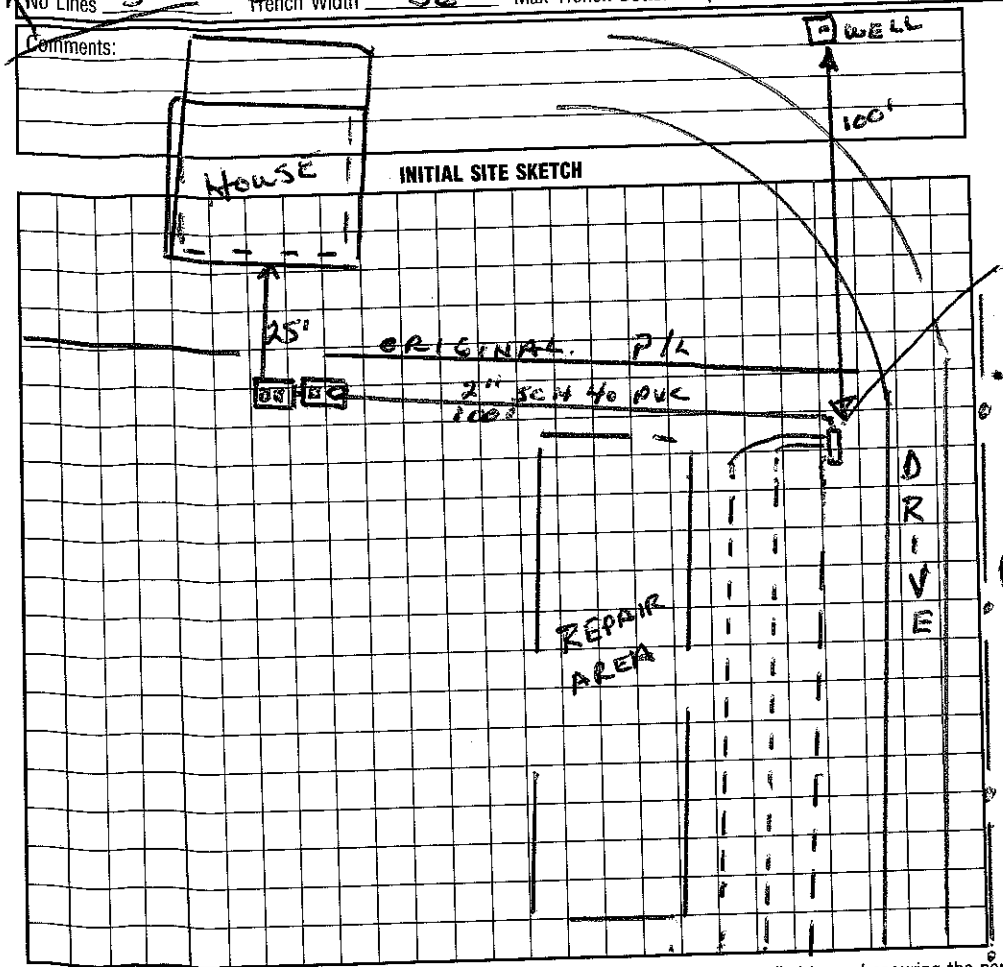

AS BUILT SKETCH

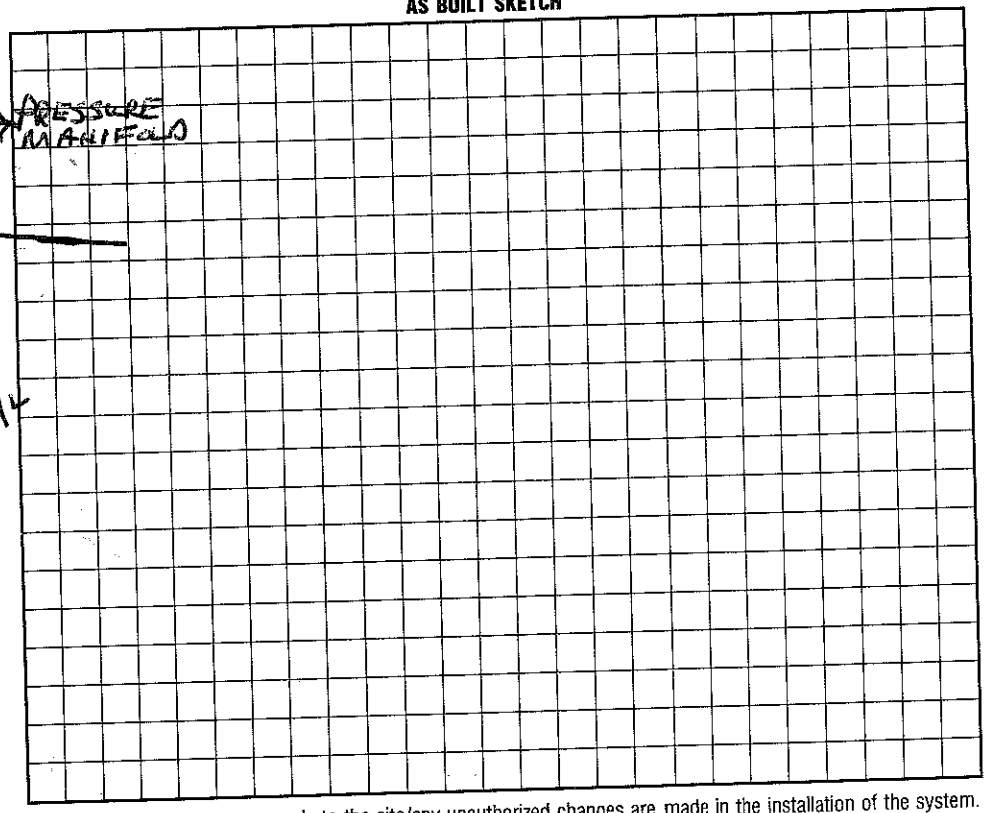

I understand that this permit can be suspended or revoked if any false information is supplied toward securing the permit/any unauthorized changes are made to the site/any unauthorized changes are made in the installation of the system.

Signed: X Allen Belk Belk + Belk Constr.

Improvement Permit by: Wesley Sparks R.S. date 10/22/96

AUTHORIZATION TO CONSTRUCT Existing System Inspection by: Wesley Sparks R.S. date 10/22/96

Installed by: Larry Beam

Certificate of Completion by: Wesley Sparks R.S. date 6/11/97

Operation Permit by: Wesley Sparks R.S. date 6/11/97

WHITE INSPECTION COPY (FINAL): GREEN OWNER COPY (FINAL): YELLOW INSPECTION COPY (INITIAL): PINK OWNER COPY (INITIAL): GOLD