# IREDELL COUNTY HEALTH DEPARTMENT

Authorization to Construct

11:00

STATESVILLE 704-878-5305 MOORESVILLE 704-664-5281

## IMPROVEMENT PERMIT / ~~CERTIFICATE OF COMPLETION~~ / OPERATION PERMIT / EXISTING SYSTEM INSPECTION

PROPERTY DESCRIPTION NO. 3908 - Mooresville Jur. DATE 6/4/96 TAX MAP NO. 1-M 16 A 2

OWNER OR CONTRACTOR Doug Treeter PHONE: Business 4658-60-8012 Home 663-8851 Watershed: ☐ Yes ☒ ~~No~~

ADDRESS 550 E Statesville Ave Apt. #12 - Mooresville

LOCATION Rinehart Rd - TL Sun Lane - Next to last lot on Rt.

SUBDIVISION Ketchie Acres BLOCK / SECTION 2 LOT 2 LOT AREA .647 ac SITE CLASS PS DESIGN FLOW 360 gpd L.T.A.R. .3 gpd/sq ft

Septic Tank: 1000 Gallons; STB 8252 Date 12/1/97

Pump Tank: _____ Gallons; PT _____ Date _____

Pump Make: _____ Model _____ Serial No. _____

Nitrification Field: No Fields 1 Square Feet 900 Linear Feet 300

No Lines 4 Trench Width 36" Max Trench Bottom Depth 36" Gravel Depth 12"

☒ New System ☐ Repair System Type: I. II. III. IV. V. VI

System Description: Gravity Conventional

Repair System Description: Pump Chamber

Maintenance Agreement Required: ☐ Yes ☒ No

☒ House/Mod. Home No. Bedrooms 3

☐ Mobile Home No. Bathrooms 2

☐ Business No. Employees _____

☐ Other _____


☐ Slab ☒ Crawl Space ☐ Basement w/plumbing ☐ Basement wo/plumbing

Water Supply:
☒ Individual
☐ Community
☐ Public


Comments:

Comments:

**INITIAL SITE SKETCH** 1"=40'

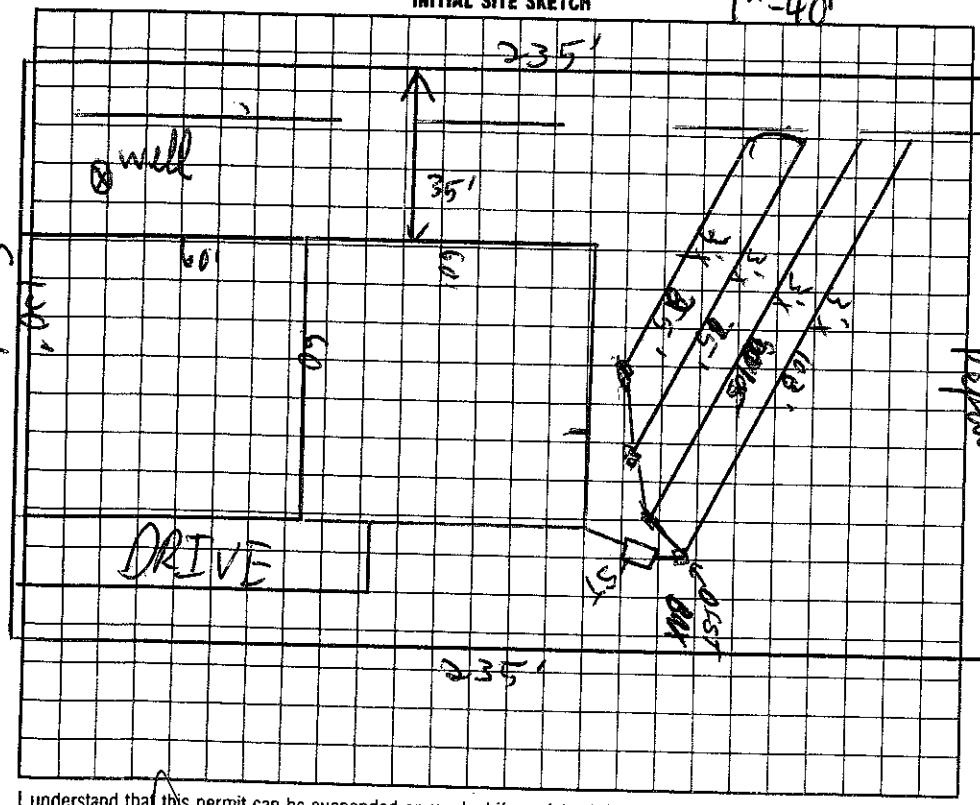


**AS BUILT SKETCH**

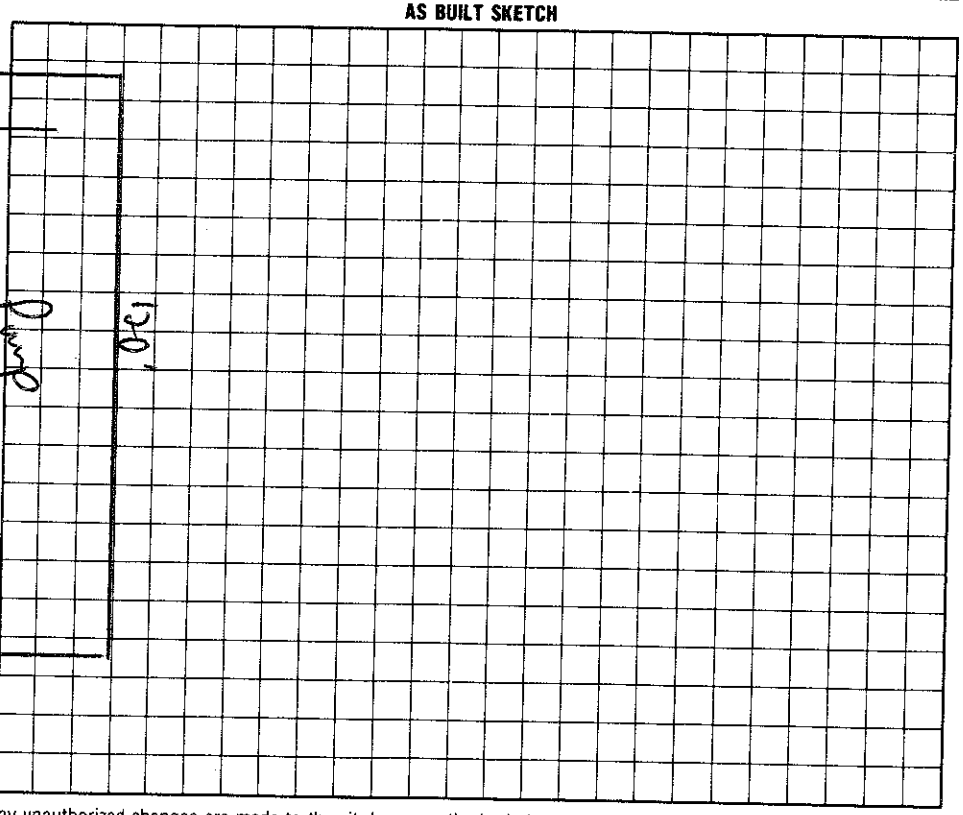


I understand that this permit can be suspended or revoked if any false information is supplied toward securing the permit/any unauthorized changes are made to the site/any unauthorized changes are made in the installation of the system.

Signed: Doug Treeter

Improvement Permit by: C. Hartgrove EHSI date 6/4/96

~~Authorization to Construct~~ Existing System Inspection by: C. Hartgrove EHSI date 6/4/96

Installed by: BOSTIAN

Certificate of Completion by: _____ date _____

Operation Permit by: C. Hartgrove RS date 3/13/98

HEALTH DEPT. COPY: WHITE INSPECTION COPY (FINAL): GREEN OWNER COPY (FINAL): YELLOW INSPECTION COPY (INITIAL): PINK OWNER COPY (INITIAL): GOLD

Authorization to Construct is valid for 60 months from issue date