IREDELL COUNTY HEALTH DEPARTMENT

STATESVILLE 704-878-5305 MOORESVILLE 704-664-5281

IMPROVEMENT PERMIT / AUTHORIZATION TO CONSTRUCT / OPERATION PERMIT / EXISTING SYSTEM INSPECTION

PERMIT# Repair PIN# 4658630444 DATE 4/29/02

OWNER OR CONTRACTOR Karyn Dick PHONE: Business Home (704) 663-6265

ADDRESS 137 Laura Rd Mooresville NC 28117

LOCATION 21N TR Laura Rd on Lt #137

SUBDIVISION BLOCK / SECTION LOT LOT AREA 0.68 Ac. SITE CLASS. PS DESIGN FLOW 360 L.T.A.R.

Septic Tank: Exist filing Gallons; STB Date

Pump Tank: Gallons; PT Date

Pump Make: Model Serial No.

Nitrification Field: No Fields Square Feet Add 375' Linear Feet 125

No Lines 2 Trench Width 36" Max Trench Bottom Depth 36" Gravel Depth —

☐ New System ☒ Repair System Type: I, II, (III), IV, V, VI

System Description: Conventional Trench Absorption

Repair System Description: Gravity 25% Rock

Maintenance Agreement Required: ☐ Yes ☐ No

☐ House/Mod. Home No. Bedrooms 3

☒ Mobile Home No. Bathrooms 2

☐ Business No. Employees

☐ Other


☐ Slab ☐ Crawl Space ☐ Basement w/plumbing ☐ Basement wo/plumbing

Water Supply: ☒ Individual ☐ Public ☐ Community Shared

Comments:/Conditions:

Comments:/Conditions:

INITIAL SITE SKETCH

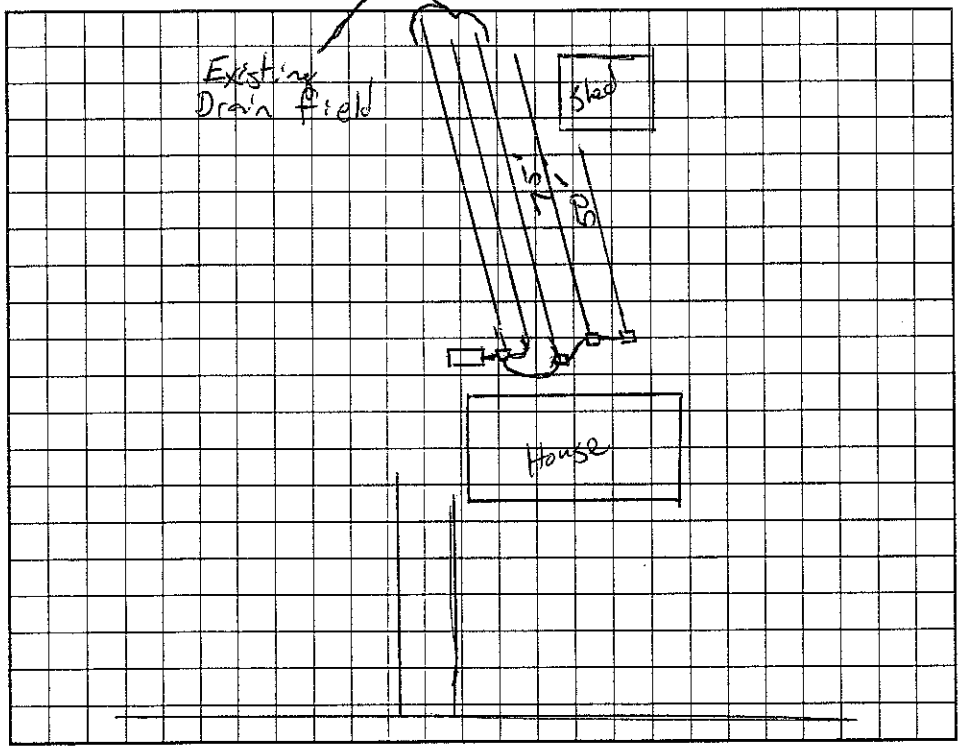

AS BUILT SKETCH

Permit can be suspended or revoked if any false information is supplied toward securing the permit/any unauthorized changes are made to the site/any unauthorized changes are made in the installation of the system. Improvement Permit with plat valid without expiration. Improvement Permit with site plan valid for sixty months. Authorization to Construct is valid for a period equal to that of Improvement Permit – not to exceed sixty months.

Signed: Eddie M. Dawson date 5/1/02 Installed by: Richard Abernathy

Improvement Permit by: [signature] RS date 4/29/02 Operation Permit by: [signature] RS date 6/18/02

Authorization to Construct by: [signature] RS date 4/29/02 Existing System Inspection by: date

HEALTH DEPT. COPY: WHITE OWNER COPY (FINAL): YELLOW OWNER COPY (INITIAL): PINK