IREDELL COUNTY HEALTH DEPARTMENT

STATESVILLE 704-878-5305 MOORESVILLE ~~704-664-5281~~

IMPROVEMENT PERMIT / AUTHORIZATION TO CONSTRUCT / OPERATION PERMIT / EXISTING SYSTEM INSPECTION

PERMIT# 088136 PIN# 4658636102 PT DATE ~~3/18/2000~~

OWNER OR CONTRACTOR Karyn Dick PHONE: Business 664-3175 (Martha) Home 663-6265

ADDRESS 137 Laura Rd Mooresville, NC 28117

LOCATION 21 N. TR Laura Rd. at end of Black Top across from Pasture

SUBDIVISION _____ BLOCK / SECTION _____ LOT _____ LOT AREA .68 Acre SITE CLASS. 03 DESIGN FLOW Existing

Septic Tank: 1000 Existing Gallons: STB _____ Date _____

Pump Tank: _____ Gallons: PT _____ Date _____

Pump Make: _____ Model _____ Serial No. _____

Nitrification Field: No Fields 1 Square Feet 900' Linear Feet 300'

No Lines 3 at ~100' ea Trench Width 36" Max Trench Bottom Depth 36" Gravel Depth 12"

☐ New System ☐ Repair System Type: I, II, III, IV, V, VI

System Description: Existing Gravity - Conventional

Repair System Description: Modified

Maintenance Agreement Required: ☐ Yes ☒ No

☒ House/Mod. Home No. Bedrooms 3

☐ Mobile Home No. Bathrooms 2

☐ Business No. Employees ____

☐ Other _____


☐ Slab ☒ Crawl Space ☐ Basement w/plumbing ☐ Basement wo/plumbing

Water Supply: ☐ Individual ☐ Public ☐ Community (Fathers)

Comments:/Conditions: Keep Septic New Home at least 5' from any part of Septic System. Existing Septic System appears to be Functioning OK, No problems Noticed at time of inspection

Comments:/Conditions: Septic System installed 1994. Copy attached.

INITIAL SITE SKETCH

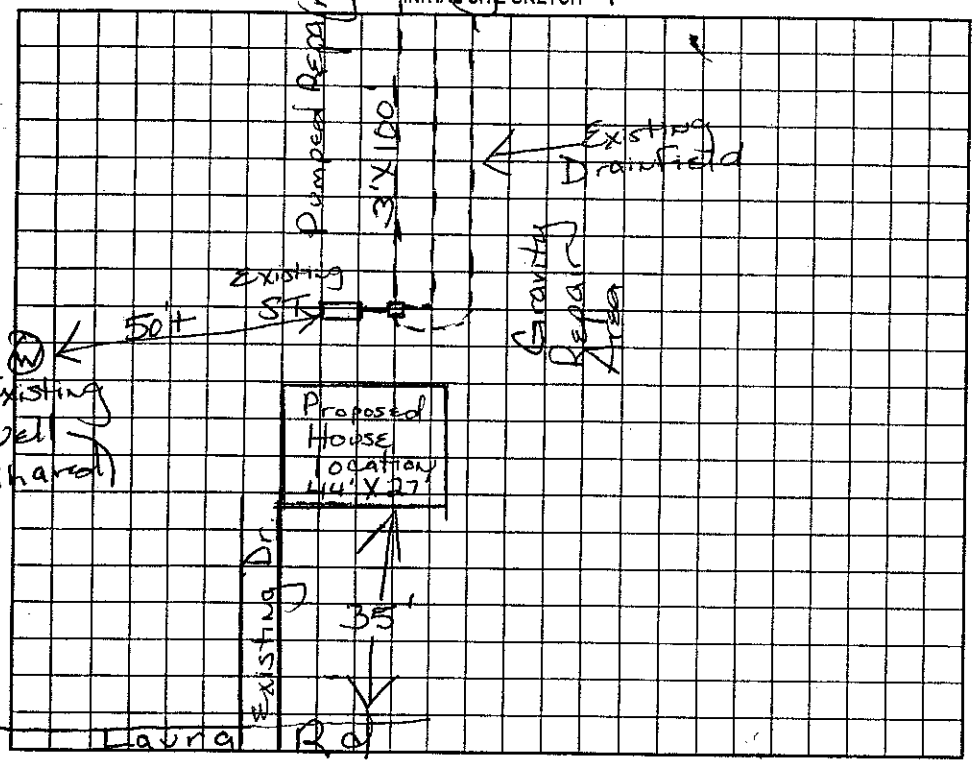

AS BUILT SKETCH

Permit can be suspended or revoked if any false information is supplied toward securing the permit/any unauthorized changes are made to the site/any unauthorized changes are made in the installation of the system. Improvement Permit with plat valid without expiration. Improvement Permit with site plan valid for sixty months. Authorization to Construct is valid for a period equal to that of Improvement Permit – not to exceed sixty months.

Signed: X Marc R. Wilk date _____

Improvement Permit by: Maina H. Dotson RS. date 3/18/2000

Authorization to Construct by: _____ date _____

Installed by: _____

Operation Permit by: _____ date _____

Existing System Inspection by: Maina H. Dotson RS date 3/18/2000