IREDELL COUNTY HEALTH DEPARTMENT

STATESVILLE 704-878-5305 MOORESVILLE 704-664-5281

IMPROVEMENT PERMIT / AUTHORIZATION TO CONSTRUCT / OPERATION PERMIT / EXISTING SYSTEM INSPECTION

PERMIT# 07205-2 PIN# 4655639972 DATE 3/3/98

OWNER OR CONTRACTOR ELSIE J CARR PHONE: Business _____ Home 660-3207

ADDRESS PO Box 1273 MOORESVILLE NC 28115

LOCATION 21 N. TR GLORY RD - ON LT

SUBDIVISION — BLOCK / SECTION — LOT [illegible] LOT AREA .554 AC SITE CLASS PS DESIGN FLOW 360 L.T.A.R. —

Septic Tank: EXISTING Gallons: STB _____ Date _____

Pump Tank: _____ Gallons; PT _____ Date _____

Pump Make: _____ Model _____ Serial No. _____

Nitrification Field: No Fields ____ Square Feet _____ Linear Feet _____

No Lines _____ Trench Width _____ Max Trench Bottom Depth _____ Gravel Depth _____

☐ New System ☐ Repair System Type: I, (II), III, IV, V, VI

System Description: GRAVITY CONVENTIONAL

Repair System Description: _____

Maintenance Agreement Required: ☐ Yes ☐ No

☐ House/Mod. Home No. Bedrooms 3

☑ Mobile Home No. Bathrooms 2

☐ Business No. Employees ____

☐ Other _____

☐ Slab ☐ Crawl Space ☐ Basement w/plumbing ☐ Basement wo/plumbing


Water Supply: ☑ Individual ☐ Public ☐ Community

Comments:/Conditions:

Comments:/Conditions:

REPLACING 3BR MOBILE HOME W/ NEW 3BR DOUBLE WIDE MH

INITIAL SITE SKETCH

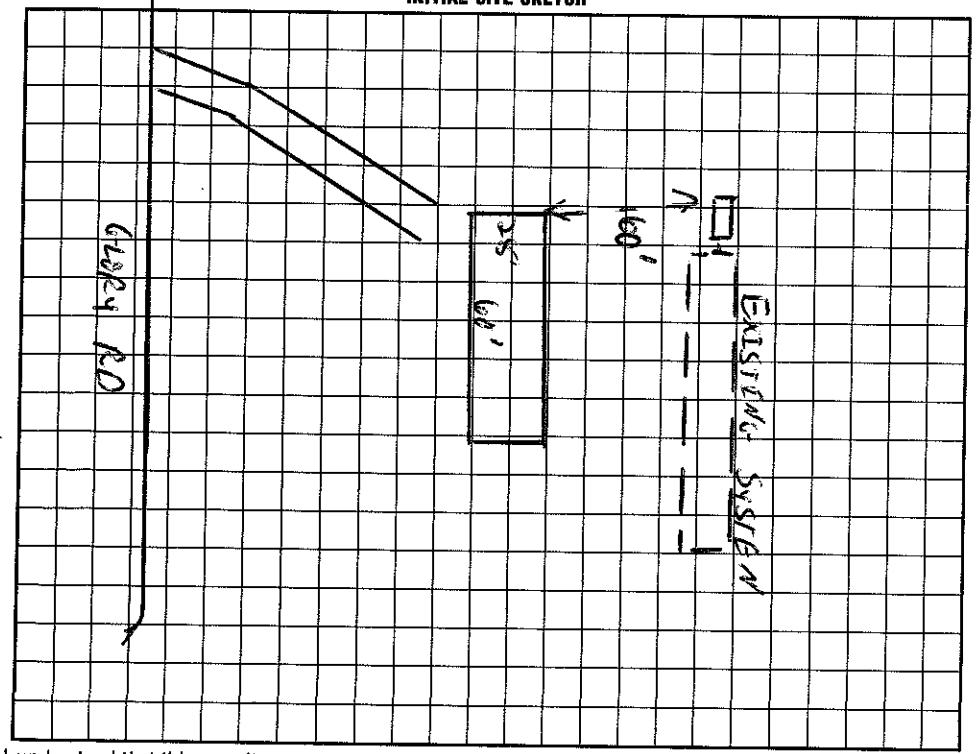

AS BUILT SKETCH

I understand that this permit can be suspended or revoked if any false information is supplied toward securing the permit/any unauthorized changes are made to the site/any unauthorized changes are made in the installation of the system. Improvement Permit with plat valid without expiration. Improvement Permit with site plan valid for sixty months. Authorization to Construct is valid for a period equal to that of Improvement Permit – not to exceed sixty months.

Signed: Elsie J Carr

Improvement Permit by: _____ date _____

Authorization to Construct by: C. [illegible] date 3/3/98

Installed by: _____

Operation Permit by: _____ date _____

Existing System Inspection by: C. [illegible] date 3/3/98

HEALTH DEPT. COPY: WHITE INSPECTION COPY (FINAL): GREEN OWNER COPY (FINAL): YELLOW INSPECTION COPY (INITIAL): PINK OWNER COPY (INITIAL): GOLD