IREDELL COUNTY HEALTH DEPARTMENT

STATESVILLE 704-878-5305 MOORESVILLE 704-664-5281

IMPROVEMENT PERMIT / CERTIFICATE OF COMPLETION / OPERATION PERMIT / EXISTING SYSTEM INSPECTION

PROPERTY DESCRIPTION NO. REPAIR DATE 1/20/95 TAX MAP NO. N/A 4658-64-0740 Watershed: ☐ Yes ☒ No

OWNER OR CONTRACTOR JACK OVERCASH - OVERCASH ELEC. PHONE: Business 664-3113 Home

ADDRESS 21N MOORESVILLE, NC.

LOCATION 21N FROM I-50W ON R ACROSS FROM LANEY'S - SMALL BRICK - 2121 Charlotte Hwy

SUBDIVISION N/A BLOCK / SECTION LOT LOT AREA SITE CLASS. P - REPAIR DESIGN FLOW 240 L.T.A.R. .25

Septic Tank: Gallons; STB Date

Pump Tank: 1000 Gallons; PT 47 Date 5/28/95

Pump Make: Model D Serial No.

Nitrification Field: No Fields 1 Square Feet 960 Sq Ft Linear Feet 320

No Lines 4 Trench Width 36" Max Trench Bottom Depth 36" Gravel Depth 12"

☒ New System ☒ Repair System Type: I, II, ☒ III, IV, V, VI

System Description: PUMP - CONV.

Repair System Description:

Maintenance Agreement Required: ☐ Yes ☒ No

☒ House/Mod. Home No. Bedrooms 2

☐ Mobile Home No. Bathrooms 1

☐ Business No. Employees

☐ Other


☐ Slab ☒ Crawl Space ☐ Basement w/plumbing ☐ Basement wo/plumbing

Water Supply: ☒ Individual ☐ Community ☐ Public BACKYARD

Comments: 5' Keep Shallow - Trench bottom 36" or less

Comments: Alarm + Pump on separate circuit breakers 5" drawdown = ~100 per dose - 12+ Maximum at (.66)

INITIAL SITE SKETCH

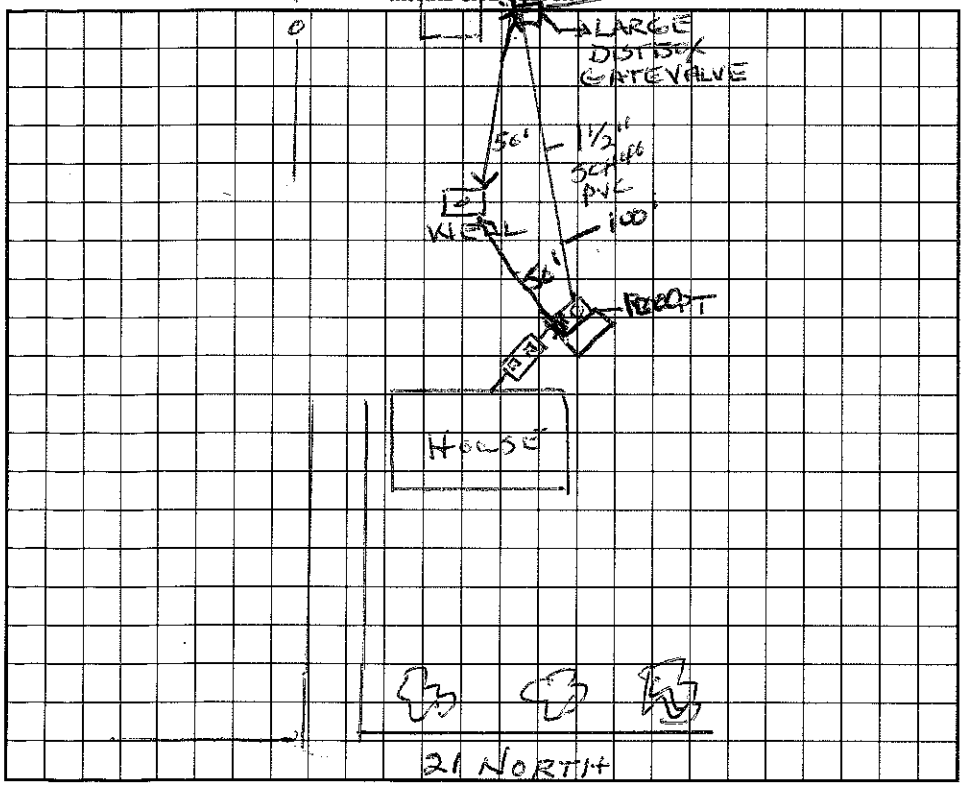

AS BUILT SKETCH

I understand that this permit can be suspended or revoked if any false information is supplied toward securing the permit/any unauthorized changes are made to the site/any unauthorized changes are made in the installation of the system. Improvement Permit is valid for 60 months from date of issuance.

Signed:

Improvement Permit by: Wesley Sparks date 1/20/95

Existing System Inspection by: date

Installed by: Tim Simmons

Certificate of Completion by: Wesley Sparks RS. date

Operation Permit by: date

HEALTH DEPT. COPY: WHITE INSPECTION COPY (FINAL): GREEN OWNER COPY (FINAL): YELLOW INSPECTION COPY (INITIAL): PINK OWNER COPY (INITIAL): GOLD