4658646845

IREDELL COUNTY HEALTH DEPARTMENT

STATESVILLE 704-878-5305 MOORESVILLE 704-664-5281

IMPROVEMENT PERMIT / CERTIFICATE OF COMPLETION / OPERATION PERMIT / EXISTING SYSTEM INSPECTION

PROPERTY DESCRIPTION NO. 16828 DATE 10/4/93 TAX MAP NO. 1M-11-A29

OWNER OR CONTRACTOR KAREN H. STEWART PHONE: Business _____ Home _____

ADDRESS Rt 1 Box 720 MOORESVILLE, NC. 28115

LOCATION GLORY RD; ON RT JUST PAST 1ST HOUSE ON (R)

SUBDIVISION N/A BLOCK / SECTION _____ LOT N/A LOT AREA .46AC SITE CLASS. P L.T.A.R. .3 - .35

Water Supply: ☑ Individual ☐ Community ☐ Public [PROPOSED]

Septic Tank: 1000 Gallons; STB _____ Date _____

Pump Tank: _____ Gallons; PT _____ Date _____

Nitrification Field: No Fields 5 Square Feet 1050 Linear Feet 350

No Lines 5 Trench Width 3' Trench Depth 28" Gravel Depth 12"

☑ New System ☐ Repair System Type: I, (II), III, IV, V, VI

System Description: CONV - GRAVITY

Repair System Description: CONV - PRESSURE

Maintenance Agreement Required: ☐ Yes ☑ No

☑ House/Mod. Home No. Bedrooms 3 Garbage Disposal: ☐ Yes ☑ No

☐ Mobile Home No. Bathrooms 2 Auto. Dishwasher: ☑ Yes ☐ No


☐ Business No. Employees _____ Auto. Washing Machine: ☑ Yes ☐ No

☐ Other _____ Other _____


☐ Slab ☑ Crawl Space ☐ Basement w/plumbing ☐ Basement wo/plumbing

Comments TIGHT! ANY QUESTIONS - ASK BEFORE INSTALLING.

INITIAL SITE SKETCH

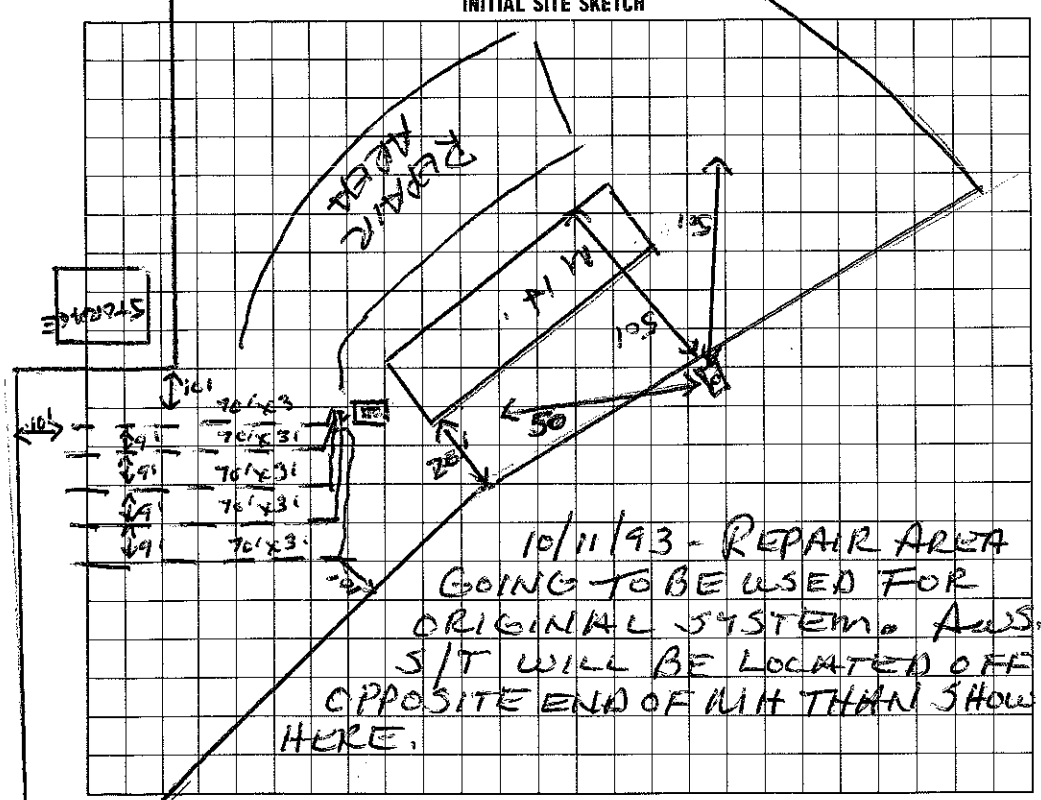

AS BUILT SKETCH

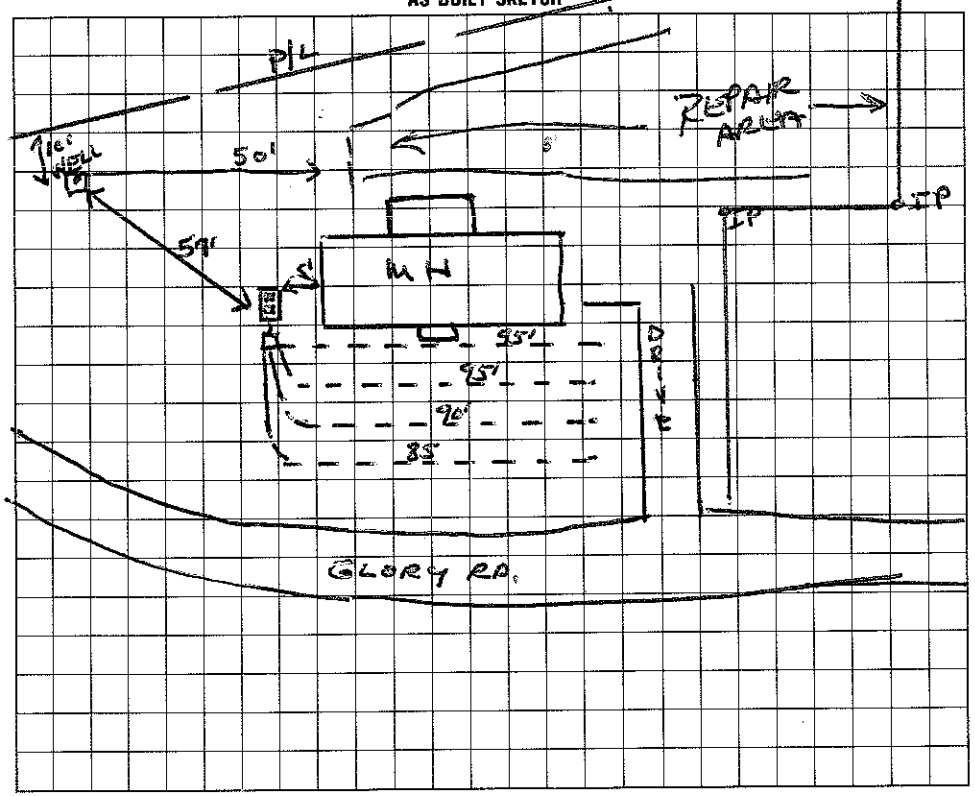

I understand that this permit can be suspended or revoked if any false information is supplied toward securing the permit/any unauthorized changes are made to the site/any unauthorized changes are made in the installation of the system. Improvement Permit is valid for 60 months from date of issuance.

Signed: _____

Improvement Permit by: Wesley Sparks RS. date 10/4/93

Existing System Inspection by: _____ date _____

Installed by: Dennis Dalbey

Certificate of Completion by: Wesley Sparks RS. date 10/19/93

Operation Permit by: _____ date _____

HEALTH DEPT. COPY: WHITE INSPECTION COPY (FINAL): GREEN OWNER COPY (FINAL): YELLOW INSPECTION COPY (INITIAL): PINK OWNER COPY (INITIAL): GOLD