IREDELL COUNTY HEALTH DEPARTMENT

AUTHORIZATION TO CONSTRUCT 4658662299

STATESVILLE 704-878-5305 MOORESVILLE 704-664-5281

IMPROVEMENT PERMIT / ~~CERTIFICATE OF COMPLETION~~ / OPERATION PERMIT / EXISTING SYSTEM INSPECTION

PROPERTY DESCRIPTION NO. 2542 7 DATE 11/1/96 TAX MAP NO. 1M-A-185 Watershed: ☑ Yes ☐ No

OWNER OR CONTRACTOR MELANIE CARVER PHONE: Business _____ Home 663-4156

ADDRESS 122 BAILEY RD MOORESVILLE NC 28115

LOCATION 215 - TR BAILEY RD - 2ND ON RT

SUBDIVISION — BLOCK / SECTION — LOT — LOT AREA ≈ 2.25 AC SITE CLASS. RS DESIGN FLOW 360 GPD L.T.A.R. EXISTING (.4)

Septic Tank: (EXISTING) 1000 Gallons; STB _____ Date _____

Pump Tank: _____ Gallons; PT _____ Date _____

Pump Make: _____ Model _____ Serial No. _____

Nitrification Field: No Fields 1 Square Feet 900 Linear Feet 300

No Lines 3 Trench Width 36" Max Trench Bottom Depth EXISTING Gravel Depth 12"

☐ New System ☐ Repair System Type: I (II) III, IV, V, VI

System Description: (EXISTING)

Repair System Description: _____

Maintenance Agreement Required: ☐ Yes ☐ No

☐ House/Mod. Home ☑ Mobile Home ☐ Business ☐ Other

No. Bedrooms 3 No. Bathrooms 2 No. Employees ____


☐ Slab ☐ Crawl Space ☐ Basement w/plumbing ☐ Basement wo/plumbing

Water Supply: ☑ Individual ☐ Community ☐ Public

Comments: KEEP MOBILE HOME 5' FROM SEPTIC SYSTEM.

Comments: PERMIT IN MELANIE O. CARVER TYPE II 1990.

INITIAL SITE SKETCH

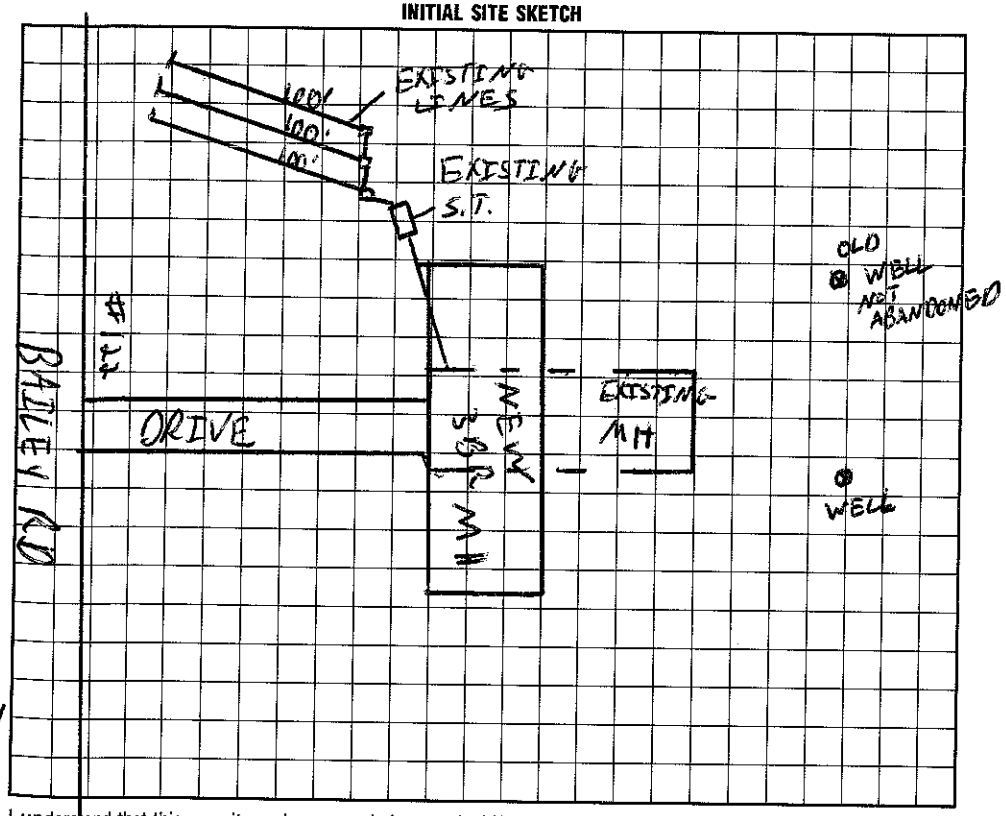

AS BUILT SKETCH

I understand that this permit can be suspended or revoked if any false information is supplied toward securing the permit/any unauthorized changes are made to the site/any unauthorized changes are made in the installation of the system.

Signed: Melanie O. Carver

Improvement Permit by: _____ date _____

Existing System Inspection by: C. Ballentine EHSI date 11/1/96

Installed by: _____

Certificate of Completion by: _____ date _____

Operation Permit by: C. Ballentine EHSI date 11/1/96

HEALTH DEPT. COPY: WHITE INSPECTION COPY (FINAL): GREEN OWNER COPY (FINAL): YELLOW INSPECTION COPY (INITIAL): PINK OWNER COPY (INITIAL): GOLD