4658665109

...TH DEPARTMENT

STATESVILLE 704-878-5305 MOORESVILLE 704-664-5281

...MENT PERMIT / CERTIFICATE OF COMPLETION / OPERATION PERMIT / EXISTING SYSTEM INSPECTI...

PROPERTY DESCRIPTION NO. 22483 DATE Nov. 21, '95 TAX MAP NO. IMA 69A Watershed: ☑ Yes ☐ No

OWNER OR CONTRACTOR Tony Moose PHONE: Business Home

ADDRESS 2050 Charlotte Hwy, Mooresville USY PA

LOCATION Hwy 21 N past Laneys Fish Camp TL Bailey Rd. 1st MH on right (~350')

SUBDIVISION BLOCK / SECTION LOT LOT AREA SITE CLASS. B DESIGN FLOW 360gpd L.T.A.R. .3

Septic Tank: 1000 Gallons; STB 1012 Date 9/12/95

Pump Tank: Gallons; PT Date

Pump Make: Model Serial No.

Nitrification Field: No Fields 1 Square Feet 1200 Linear Feet 400

No Lines 4@100' Trench Width 36" Max Trench Bottom Depth 36"+ Gravel Depth 12"

☑ New System ☐ Repair System Type: I, II, III, IV, V, VI

System Description: gravity conventional

Repair System Description: same

Maintenance Agreement Required: ☐ Yes ☑ No

☐ House/Mod. Home No. Bedrooms 3

☑ Mobile Home No. Bathrooms 2

☐ Business No. Employees

☐ Other


☐ Slab ☑ Crawl Space ☐ Basement w/plumbing ☐ Basement wo/plumbing

Water Supply: ☑ Individual 4ex ☐ Community ☐ Public

Comments: Install nitrification trenches at 36" trench bottom depth.

Comments:

INITIAL SITE SKETCH

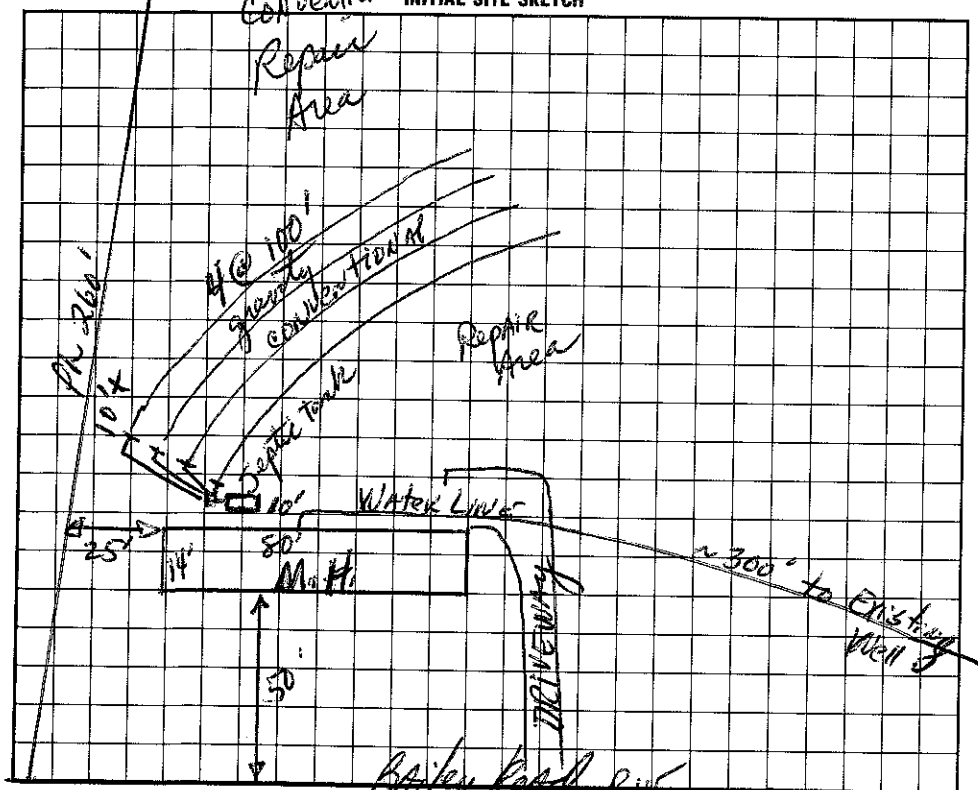

AS BUILT SKETCH

System Installed According To Layout

I understand that this permit can be suspended or revoked if any false information is supplied toward securing the permit/any unauthorized changes are made to the site/any unauthorized changes are made in the installation of the system.

Signed: Tony Moose

Improvement Permit by: Dana Hamm RS date 11-21-95

Existing System Inspection by: Dana Hamm RS date 11-21-95

Approved to construct

Installed by: Clyde Taylor & Son

Certificate of Completion by: date 12/6/95

Operation Permit by: date

HEALTH DEPT. COPY: WHITE INSPECTION COPY (FINAL): GREEN OWNER COPY (FINAL): YELLOW INSPECTION COPY (INITIAL): PINK OWNER COPY (INITIAL): GOLD