IREDELL COUNTY HEALTH DEPARTMENT

IMPROVEMENT PERMIT / AUTHORIZATION TO CONSTRUCT / OPERATION PERMIT / EXISTING SYSTEM INSPECTION

STATESVILLE 704-878-5305 MOORESVILLE 704-664-5281

PERMIT# 081500 PIN# 4658666057 DATE 6/10/99

OWNER OR CONTRACTOR Tony Moose PHONE: Business Home 664-5470

ADDRESS 110 Bailey Rd - 2050 Charlotte Hwy Mooresville, NC 28115

LOCATION 110 Bailey Rd. Take 21 N TL Bailey Rd - 1st House on Rt.

SUBDIVISION BLOCK / SECTION LOT LOT AREA SITE CLASS. DESIGN FLOW 360gpd L.T.A.R. Existing

Septic Tank: 1000 Gallons; STB Date

Pump Tank: Gallons; PT Date

Pump Make: Model Serial No.

Nitrification Field: No Fields 1 Square Feet 1200 Linear Feet 400

No Lines 4 at 100' Trench Width 36" Max Trench Bottom Depth 36" Gravel Depth 12"

☒ New System ☐ Repair System Type: I, (II), III, IV, V, VI

System Description: Existing Gravity Conventional

Repair System Description: Same

Maintenance Agreement Required: ☐ Yes ☒ No

☐ Slab ☒ Crawl Space ☐ Basement w/plumbing ☐ Basement wo/plumbing

☐ House/Mod. Home ☒ Mobile Home ☐ Business ☐ Other


No. Bedrooms 3 No. Bathrooms 2 No. Employees

Water Supply: ☒ Individual ☐ Public ☐ Community

Comments:/Conditions: ~~Originally installed 12/6/95~~

Comments:/Conditions: Existing Septic System appeared to be functioning okay at time of inspection, No problem noticed. Setting on 3Bdrm MH

INITIAL SITE SKETCH

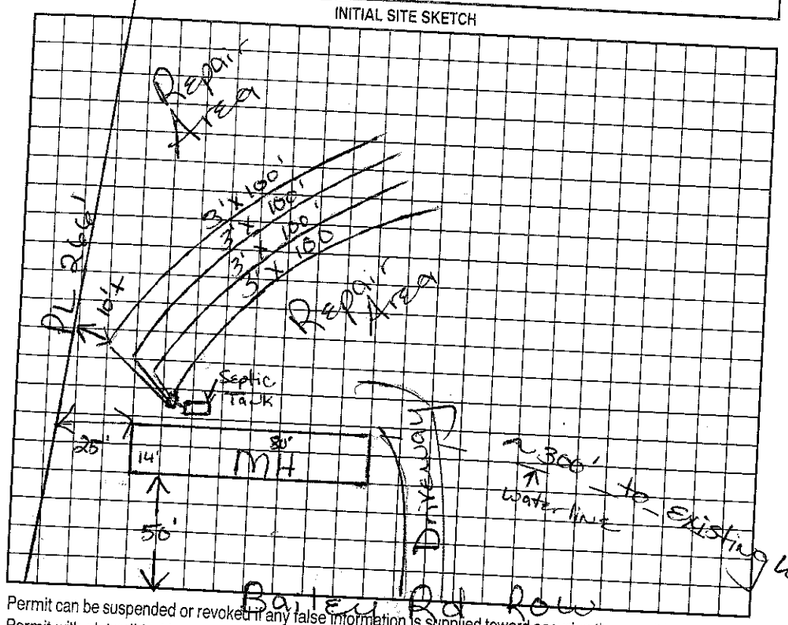

AS BUILT SKETCH

Permit can be suspended or revoked if any false information is supplied toward securing the permit/any unauthorized changes are made to the site/any unauthorized changes are made in the installation of the system. Improvement Permit with plat valid without expiration. Improvement Permit with site plan valid for sixty months. Authorization to Construct is valid for a period equal to that of Improvement Permit -- not to exceed sixty months.

Signed: X

Improvement Permit by: Maria H. Dotson R.S. date 6/10/99

Authorization to Construct by: Maria Dotson date 6/10/99

Installed by:

Operation Permit by:

Existing System Inspection by: Maria Dotson R.S. date 6/10/99

HEALTH DEPT. COPY: WHITE OWNER COPY (FINAL): YELLOW OWNER COPY (INITIAL): PINK