IREDELL COUNTY HEALTH DEPARTMENT

STATESVILLE 704-878-5305 MOORESVILLE 704-664-5281

IMPROVEMENT PERMIT / AUTHORIZATION TO CONSTRUCT / OPERATION PERMIT / EXISTING SYSTEM INSPECTION

PERMIT# 4319 PIN# 1M1614A 4658 70 0050 DATE 1/5/98

OWNER OR CONTRACTOR BILL HUNTER PHONE: Business Home 664-8088

ADDRESS 626 HEATHERLY RD MOORESVILLE 28115

LOCATION 150 E-TO RHINEHART LN- TL SHAW LN

SUBDIVISION KETCHIE ACRES BLOCK / SECTION 2 LOT 4 LOT AREA .654c SITE CLASS. PS DESIGN FLOW 360 GPD L.T.A.R. .30 GPD/FT

Septic Tank: 1000 Gallons; STB 1017 Date 6/2/98

Pump Tank: 1000 Gallons; PT 17 Date 1/10/97

Pump Make: Model Serial No.

Nitrification Field: No Fields 1 Square Feet 900 Linear Feet 300

No Lines 4 @ 75' Trench Width 36" Max Trench Bottom Depth 36" Gravel Depth 24

☑ New System ☐ Repair System Type: I, II, III, IV, V, VI

System Description: PUMP CHAMBERED ORTHO'S

Repair System Description: SAME

Maintenance Agreement Required: ☐ Yes ☑ No

☑ House/Mod. Home ☐ Mobile Home ☐ Business ☐ Other

No. Bedrooms 3 No. Bathrooms 2 No. Employees


☐ Slab ☑ Crawl Space ☐ Basement w/plumbing ☐ Basement wo/plumbing

Water Supply: ☑ Individual ☐ Public ☐ Community


Comments:/Conditions:

Comments:/Conditions: Pressure checked 12/30/98 MD

INITIAL SITE SKETCH 1"=50'

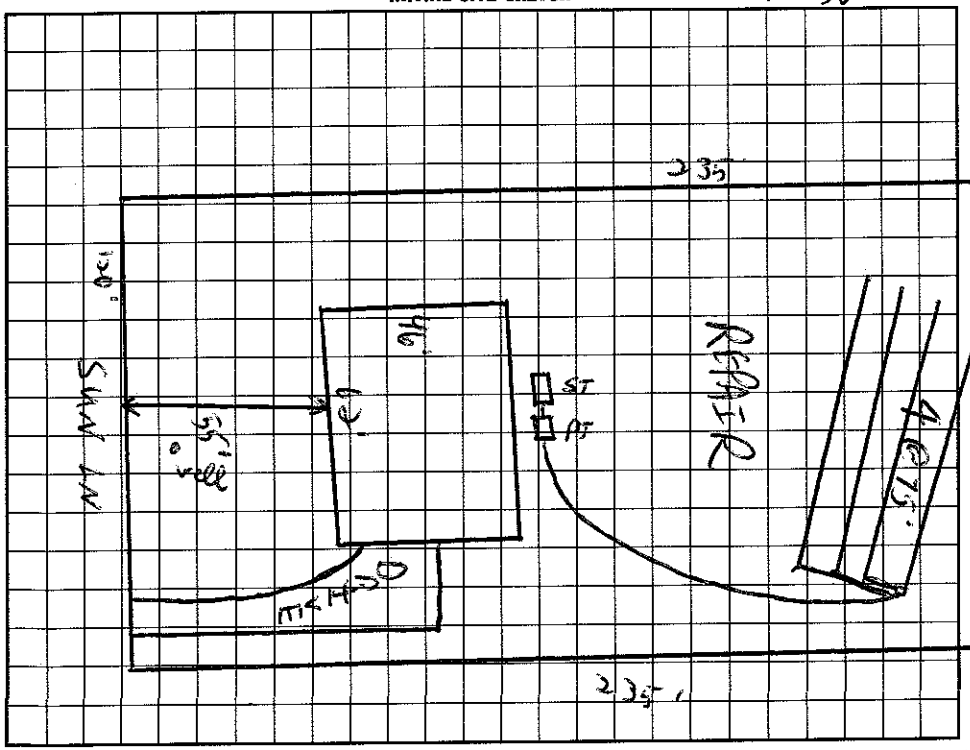

AS BUILT SKETCH

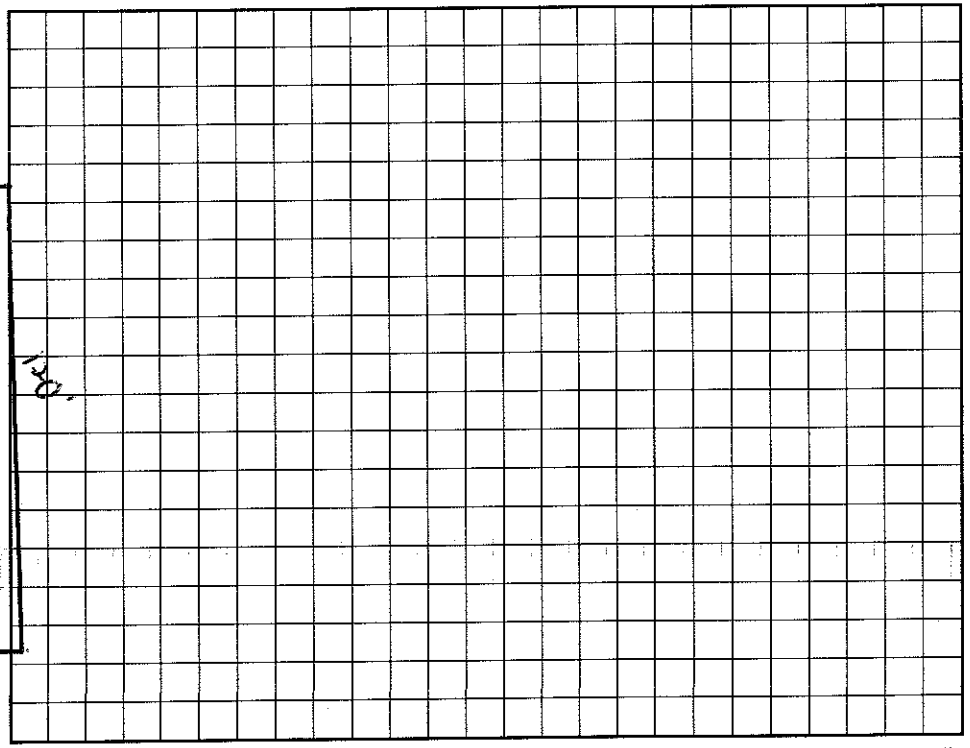

I understand that this permit can be suspended or revoked if any false information is supplied toward securing the permit/any unauthorized changes are made to the site/any unauthorized changes are made in the installation of the system. Improvement Permit with plat valid without expiration. Improvement Permit with site plan valid for sixty months. Authorization to Construct is valid for a period equal to that of Improvement Permit – not to exceed sixty months.

Signed: _____ date 1/5/97

Improvement Permit by: _____ date 1/5/97

Authorization to Construct by: _____ date 1/5/97

Installed by: Forest Stafford

Operation Permit by: _____ date 12/31/98

Existing System Inspection by: _____ date _____

HEALTH DEPT. COPY: WHITE INSPECTION COPY (FINAL): GREEN OWNER COPY (FINAL): YELLOW INSPECTION COPY (INITIAL): PINK OWNER COPY (INITIAL): GOLD