IREDELL COUNTY HEALTH DEPARTMENT

STATESVILLE 704-878-5305 MOORESVILLE 704-664-5281

IMPROVEMENT PERMIT / CERTIFICATE OF COMPLETION / OPERATION PERMIT / EXISTING SYSTEM INSPECTION

PROPERTY DESCRIPTION NO. 2447 DATE 9/29/93

OWNER OR CONTRACTOR RP RUDISILL INC TAX MAP NO. 1M 16 A 7

ADDRESS Rt 1 Box 102C TROUTMAN, NC. 28166 PHONE: Business 528-3449 Home 4658-70-4010

LOCATION KETCHIE DR. © OFF RINEHART RD. TO 2ND lot on (R)

SUBDIVISION KETCHIE ACRES BLOCK / SECTION 2 LOT 7 LOT AREA ~1.71 AC SITE CLASS. P. L.T.A.R. .25 - .3

Water Supply: ☐ Individual ☐ Community ☐ Public

Septic Tank: 1000 Gallons; STB 782 Date 2/25/94

Pump Tank: _____ Gallons; PT _____ Date _____

Nitrification Field: No Fields 1 Square Feet 1200 Linear Feet 400

No Lines 3 Trench Width 3' Trench Depth 24-28" Gravel Depth 12"

☑ New System ☐ Repair System Type: I, (II), II, IV, V, VI

System Description: CONV - DIST BOX

Repair System Description: CONV.

Maintenance Agreement Required: ☐ Yes ☑ No

☑ House/Mod. Home No. Bedrooms 3

☐ Mobile Home No. Bathrooms 2

☐ Business No. Employees _____

☐ Other _____

Garbage Disposal: ☐ Yes ☑ No

Auto. Dishwasher: ☑ Yes ☐ No


Auto. Washing Machine: ☑ Yes ☐ No

Other _____


☐ Slab ☑ Crawl Space ☐ Basement w/plumbing ☐ Basement wo/plumbing

Comments TRENCH DEPTH 28" - LINES SOLID 4" UNDER DRIVE - SLEEVED THRU 6" DOT STANDARD CULVERT - 1 PER LINE

INITIAL SITE SKETCH

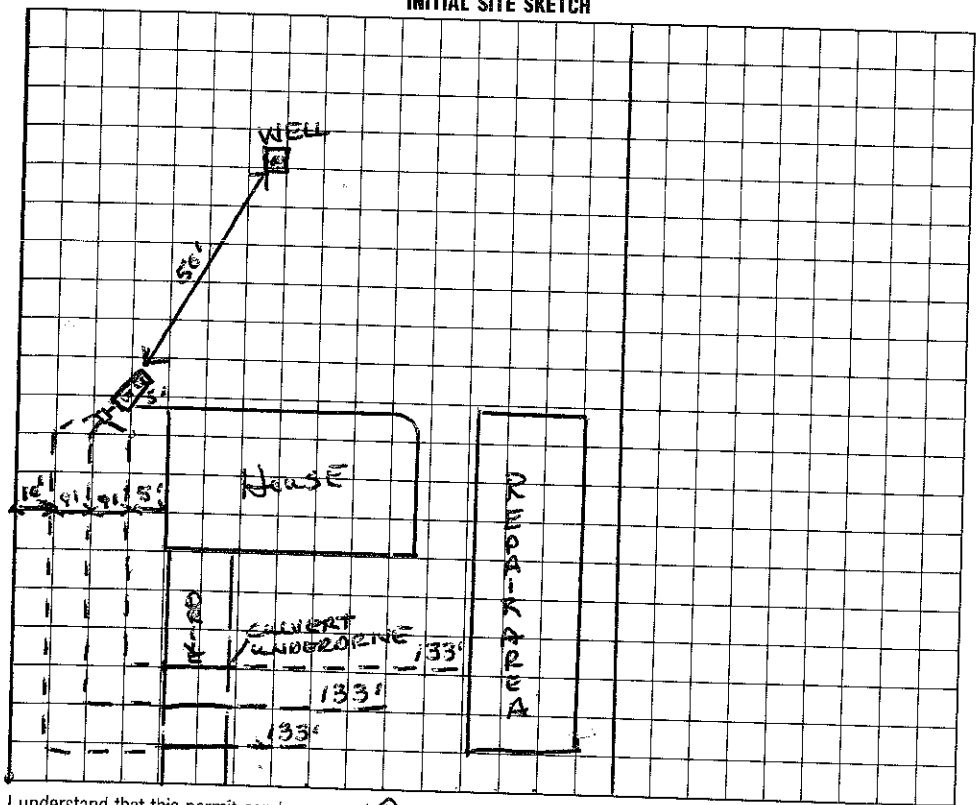

AS BUILT SKETCH

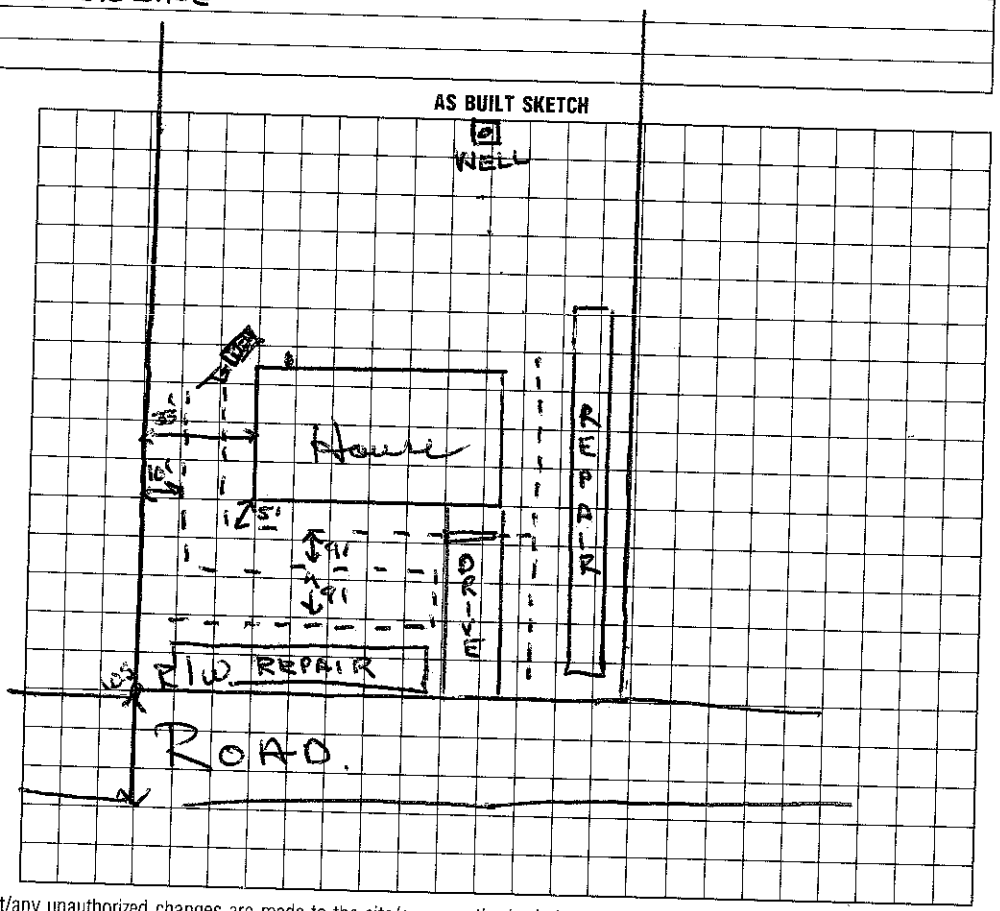

I understand that this permit can be suspended or revoked if any false information is supplied toward securing the permit/any unauthorized changes are made to the site/any unauthorized changes are made in the installation of the system. Improvement Permit is valid for 60 months from date of issuance.

Signed: Robert Rudisill, Pres.

Improvement Permit by: Wesley Sparks R.S. date 9/29/93

Existing System Inspection by: _____ date _____

Installed by: Delbert Bostian

Certificate of Completion by: Wesley Sparks R.S. date 3/23/94

Operation Permit by: _____ date _____

HEALTH DEPT. COPY: WHITE INSPECTION COPY (FINAL): GREEN OWNER COPY (FINAL): YELLOW INSPECTION COPY (INITIAL): PINK OWNER COPY (INITIAL): GOLD