IREDELL COUNTY HEALTH DEPARTMENT

STATESVILLE 704-878-5305 MOORESVILLE 704-664-5281

IMPROVEMENT PERMIT / AUTHORIZATION TO CONSTRUCT / OPERATION PERMIT / EXISTING SYSTEM INSPECTION

PERMIT # 155074/155073 PIN # 4658 70 6512 DATE 3/3/09

OWNER or APPLICANT THOMAS MILLER PHONE: Business 704 363 5891 Home:

OWNER or APPLICANT ADDRESS 252 RINEHARDT RD. MOORESVILLE, NC. 28117

LOCATION / DIRECTIONS 252 RINEHARDT RD.

SUBDIVISION N/A BLOCK / SECTION LOT # N/A LOT AREA 1.978 DESIGN FLOW 360 L.T.A.R.

Septic Tank 1000 (EXISTING) Gallons: STB Date

Pump Tank Gallons: P T Date

Pump Make Model Serial #

Nitrification Field No Fields No Lines 3 Linear Feet 240

Trench Width 3' Max. Trench Bottom Depth EXISTING SYSTEM Gravel Depth

☐ New System ☐ Repair ☐ Expansion System Type I (II) III IV V VI

System Description: EXISTING SYSTEM

Repair System Description:

Maintenance Agreement Required ☐ YES ☒ NO

☒ GRAVITY ☐ PRESSURE

☒ Residence No. Bedrooms 3

☐ Business No. Persons

☐ Other No. Employees

☐ Slab ☐ Crawl Space


☐ Basement w/plumbing ☐ Basement w/o plumbing

Water Supply: ☒ Private ☐ Public ☐ Community

Comments / Conditions

AS BUILT SKETCH 9/08

~~INITIAL SITE SKETCH~~

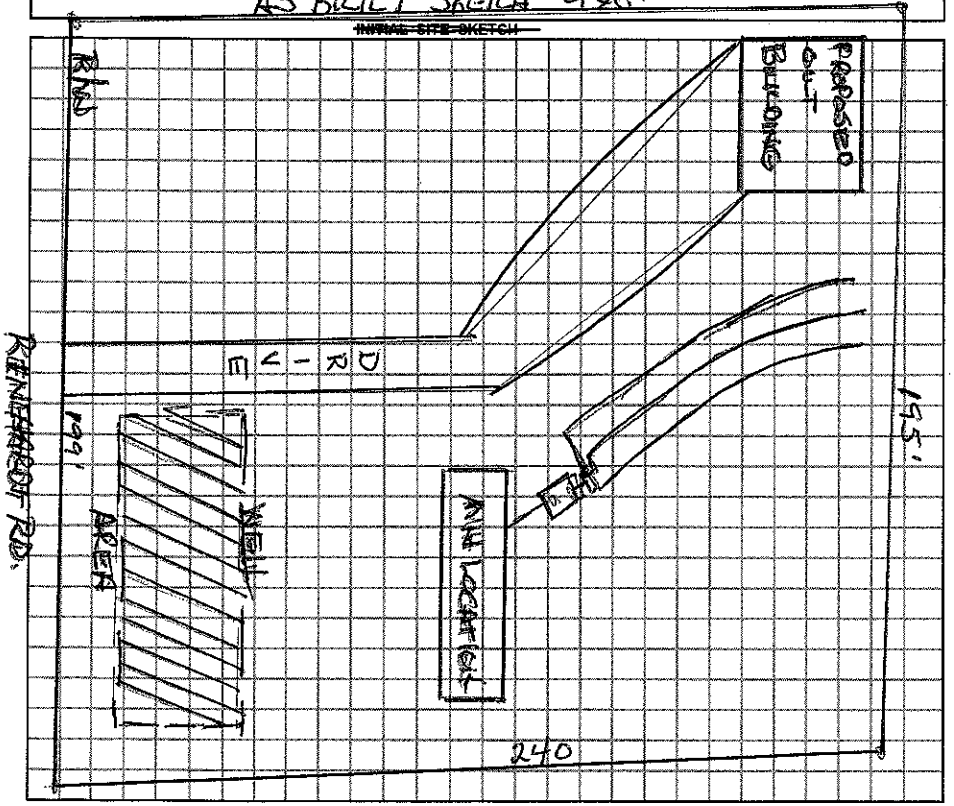

Comments / Conditions

AS BUILT SKETCH

Permit can be suspended or revoked if any false information is supplied toward securing the permit / any unauthorized changes are made to the site / any unauthorized changes are made in the installation of the system.

☐ *IMPROVEMENT PERMIT w / plat valid without expiration.* ☐ *IMPROVEMENT PERMIT w / site plan valid for 60 mos.* ☐ *AUTHORIZATION TO CONSTRUCT valid for period equal to IMPROVEMENT PERMIT-not to exceed 60 mo.*

Owner / Applicant Signature Thomas M Miller Date 3/4/09

Improvement Permit by: Date

Authorization to Construct by: Date

YOU SHOULD CONTACT A LOCATOR SERVICE PRIOR TO ANY EXCAVATION.

Installed by:

Operation Permit by: Date:

Existing System Inspected by: Wesley Sparks, RS. Date: 3/3/09

WHITE COPY Environmental Health YELLOW COPY (Final) Owner / Applicant PINK COPY (Initial) Owner / Applicant