IREDELL COUNTY HEALTH DEPARTMENT

STATESVILLE 704-878-5305 MOORESVILLE 704-664-5281

IMPROVEMENT PERMIT / CERTIFICATE OF COMPLETION / OPERATION PERMIT / EXISTING SYSTEM INSPECTION

PROPERTY DESCRIPTION NO. 2318 DATE 9/28/93 TAX MAP NO. 1MA57

OWNER OR CONTRACTOR ROBERT C WAUGH PHONE: Business 664-3893 Home 4658 70 8571

ADDRESS

LOCATION RINEHART RD.

SUBDIVISION ERVIN PROP. BLOCK / SECTION LOT 1 LOT AREA ~1.95A SITE CLASS. A L.T.A.R. .25-.3

Water Supply: ☑ Individual ☐ Community ☐ Public SN 2400202 Gould WE05 11HH

Septic Tank: 1000 ~~1250~~ Gallons; STB 358 Date 9/22/93

Pump Tank: 1000 1250 Gallons; PT 103 Date 9/7/93

Nitrification Field: No Fields 1 Square Feet 400 Linear Feet 1200

No Lines 4 Trench Width 3' Trench Depth 30" Gravel Depth 12"

☑ New System ☐ Repair System Type: I, (II), II, IV, V, VI

System Description: CONV - PRES. MANIFOLD

Repair System Description:

Maintenance Agreement Required: ☐ Yes ☑ No

☑ House/Mod. Home No. Bedrooms 3 Garbage Disposal: ☑ Yes ☐ No

☐ Mobile Home No. Bathrooms 2 Auto. Dishwasher: ☑ Yes ☐ No

☐ Business No. Employees Auto. Washing Machine: ☑ Yes ☐ No


☐ Other Other GARAGE

☐ Slab ☑ Crawl Space ☐ Basement w/plumbing ☐ Basement wo/plumbing


Comments PRESSURE MANIFOLD SYSTEM
REPAIR AREA BELOW, REPAIR AREA FOR CAMPBELL SYSTEM

CLAY - IIA SOILS.

INITIAL SITE SKETCH

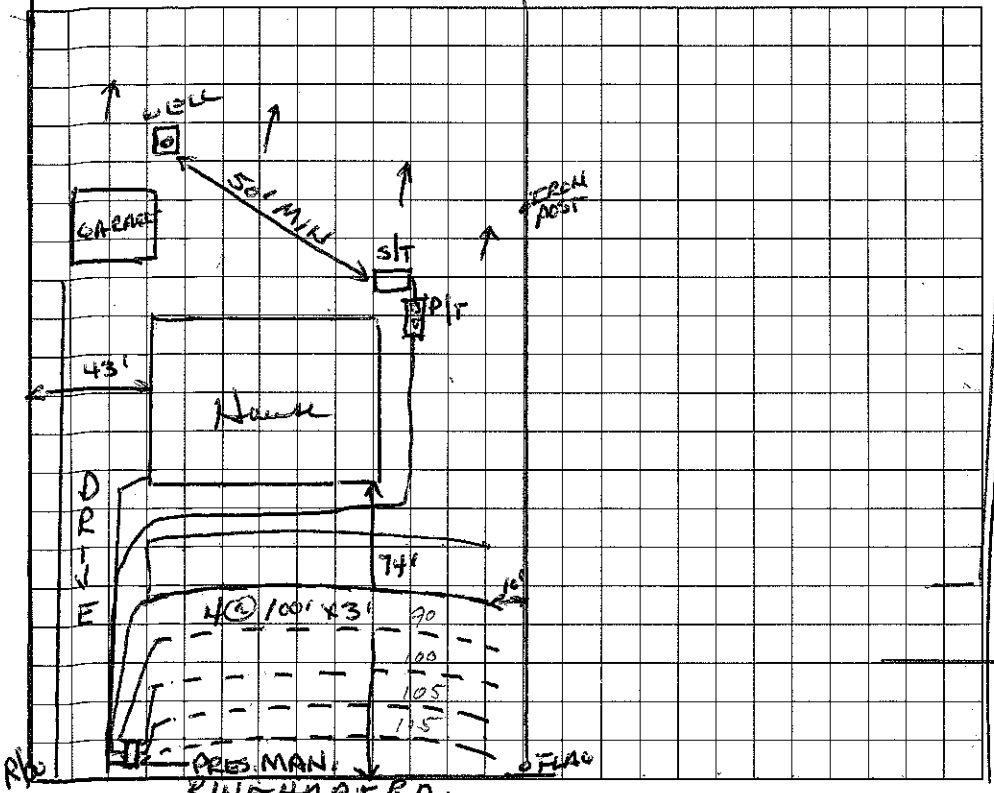

AS BUILT SKETCH

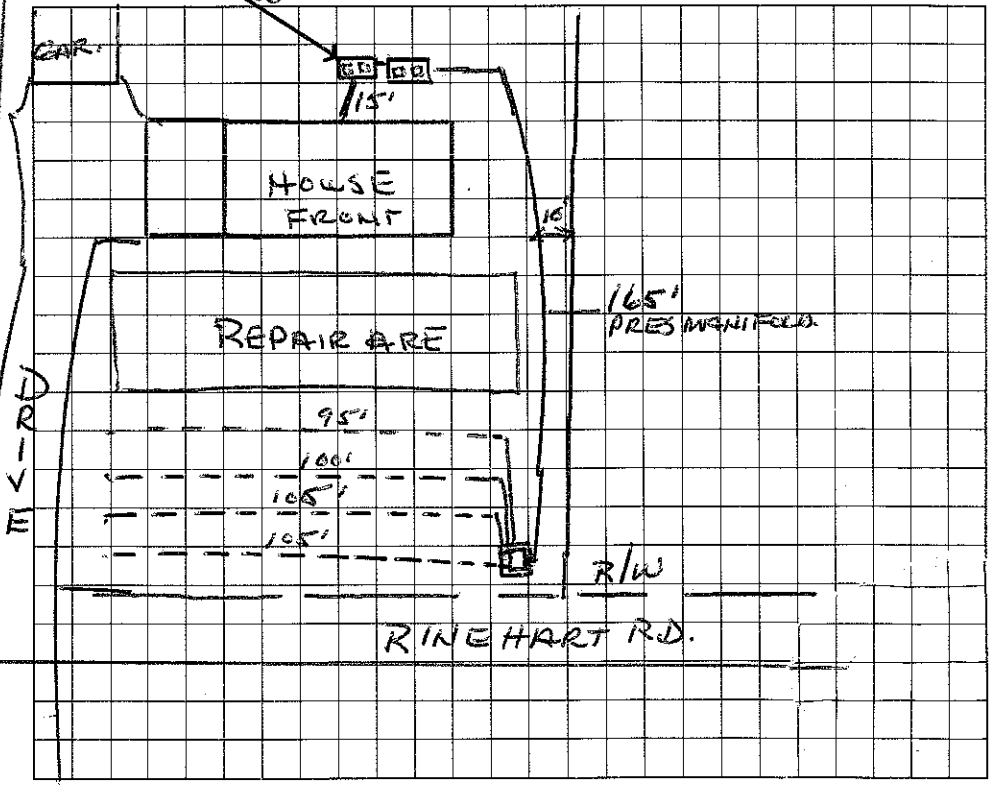

I understand that this permit can be suspended or revoked if any false information is supplied toward securing the permit/any unauthorized changes are made to the site/any unauthorized changes are made in the installation of the system. Improvement Permit is valid for 60 months from date of issuance.

Signed:

Improvement Permit by: Wesley Sparks R.S. date 9/28/93

Existing System Inspection by: date

Installed by: Wayne Orbison

Certificate of Completion by: Wesley Sparks R.S. date 9/28/93

Operation Permit by: date

HEALTH DEPT. COPY: WHITE INSPECTION COPY (FINAL): GREEN OWNER COPY (FINAL): YELLOW INSPECTION COPY (INITIAL): PINK OWNER COPY (INITIAL): GOLD