IREDELL COUNTY HEALTH DEPARTMENT

STATESVILLE 704-878-5305 MOORESVILLE 704-664-5281

IMPROVEMENT PERMIT / CERTIFICATE OF COMPLETION / OPERATION PERMIT / EXISTING SYSTEM INSPECTION

PROPERTY DESCRIPTION NO. 2319 DATE 10/7/93 TAX MAP NO. IMA57

OWNER OR CONTRACTOR DAVID + MICHELLE CAMPBELL PHONE: Business Home 4658 TO 8679

ADDRESS RINEHART RD. MOORESVILLE

LOCATION RINEHART RD. ON (R) FROM 150 BEFORE BIG CURVE

SUBDIVISION DE ERVIN BLOCK / SECTION LOT 2 LOT AREA ± 1.3 AC SITE CLASS. P L.T.A.R. .3

Water Supply: ☑ Individual ☐ Community ☐ Public

Septic Tank: 1500 Gallons; STB 780 Date 8/12/93

Pump Tank: 1500 Gallons; PT 184 Date 8/9/93

Nitrification Field: No Fields 1 Square Feet 1600 Linear Feet 533

No Lines 4 Trench Width 3' Trench Depth 3' Gravel Depth 12"

☑ New System ☐ Repair System Type: I, II, (II), IV, V, VI

System Description: PRES. MANIFOLD - CONV.

Repair System Description PREMANIFOLD - PPBAS

Maintenance Agreement Required: ☐ Yes ☑ No

☑ House/Mod. Home ☐ Mobile Home ☐ Business ☐ Other

No. Bedrooms 4 No. Bathrooms 2 No. Employees

☐ Slab ☑ Crawl Space ☑ Basement w/plumbing ½ ☐ Basement wo/plumbing

Garbage Disposal: ☑ Yes ☐ No


Auto. Dishwasher: ☑ Yes ☐ No

Auto. Washing Machine: ☑ Yes ☐ No


Other

Comments

INITIAL SITE SKETCH

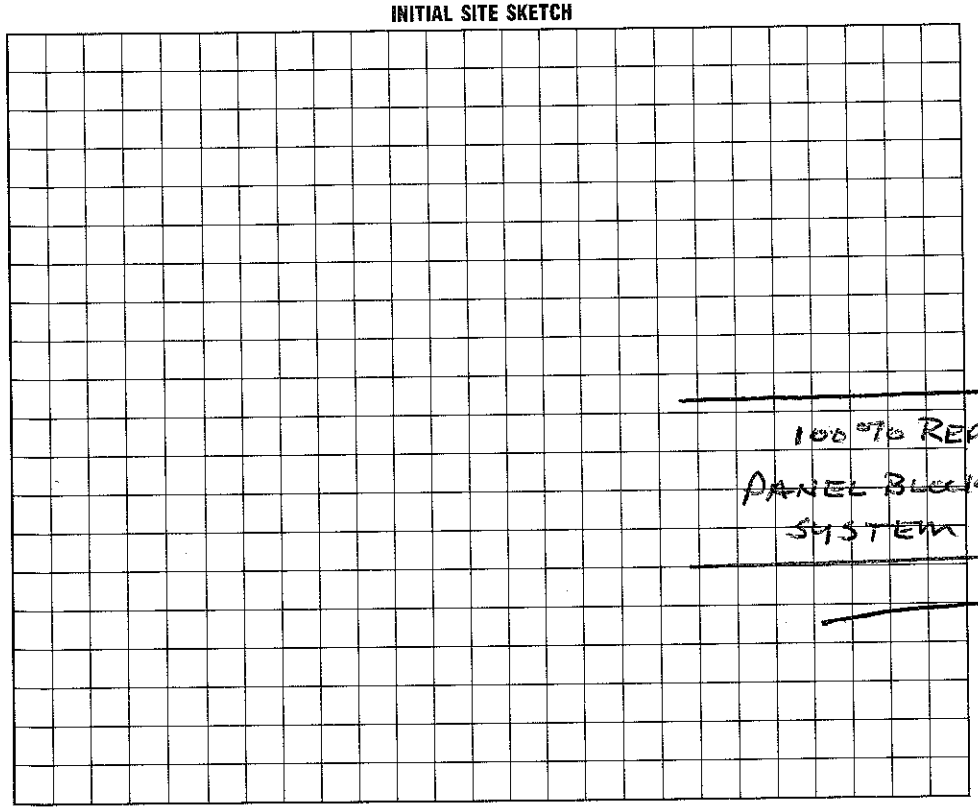

AS BUILT SKETCH

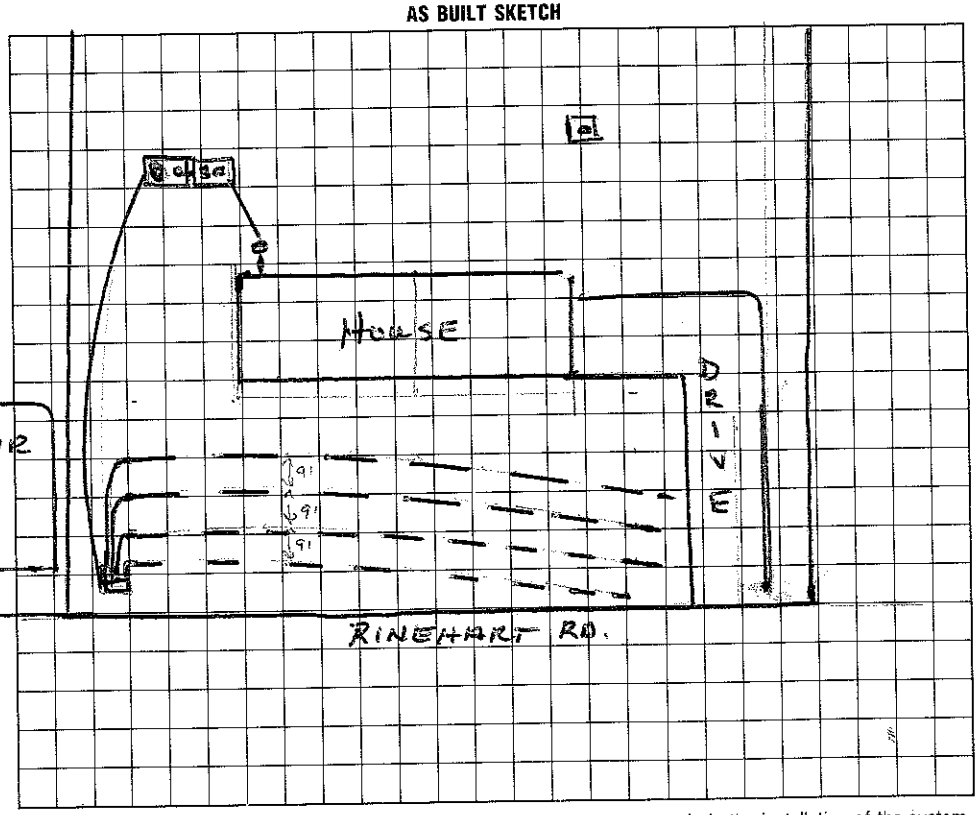

I understand that this permit can be suspended or revoked if any false information is supplied toward securing the permit/any unauthorized changes are made to the site/any unauthorized changes are made in the installation of the system. Improvement Permit is valid for 60 months from date of issuance.

Signed:

Improvement Permit by: date

Existing System Inspection by: date

Installed by: WAYNE ORBISON

Certificate of Completion by: Wesley Sparks RS. date 10/1/93

Operation Permit by: Wesley Sparks RS. date 10/1/93

HEALTH DEPT. COPY: WHITE INSPECTION COPY (FINAL): GREEN OWNER COPY (FINAL): YELLOW INSPECTION COPY (INITIAL): PINK OWNER COPY (INITIAL): GOLD