4.00

IREDELL COUNTY HEALTH DEPARTMENT - *ENVIRONMENTAL HEALTH* ☐ STATESVILLE OFFICE 704-878-5305 ☐ MOORESVILLE OFFICE 704-664-5281

IMPROVEMENT PERMIT / AUTHORIZATION TO CONSTRUCT / OPERATION PERMIT / EXISTING SYSTEM INSPECTION

PERMIT # 169571 PIN # 4658710243 DATE 12-12-2011

OWNER Arnold Howard APPLICANT: Same PHONE: Home/Cell # 864 561-6621 Business # 864 978-9233

SITE ADDRESS Red Dog Dr OWNER / APPLICANT ADDRESS 222 Rinehardt Rd. Mooresville, NC 28115

SITE DIRECTIONS Hwy 150 E TL Rinehardt Rd TL Red Dog on Right

SUBDIVISION LW Blackwelder BLOCK / SECTION LOT # Tract 3 LOT AREA DESIGN FLOW 360gpd L.T.A.R. .3

Septic Tank 1000 Gallons: STB 760 Date 2-26-07 ☒ New System ☐ Repair ☐ Expansion System Type I II III IV V VI

Pump Tank Gallons: P T Date System Description: Gravity -- 25% Reduction

Pump Make Model Serial # Repair System Description: Same

No. Nitrification Fields: 1 No. Lines 4 Linear Feet 300FT Maintenance Agreement Required ☐ YES ☒ NO

Trench Width 36" Max. Trench Bottom Depth 36 Gravel Depth N/A ☒ GRAVITY ☐ PRESSURE


☒ Residence No. Bedrooms 3 — Water Supply: ☒ Private ☐ Public ☐ Community

☐ Business No. Persons ☐ Other No. Employees ☒ Slab ☐ Crawl Space ☐ Basement w/plumbing ☐ Basement w/o plumbing


Comments / Conditions: Must keep Septic System 100ft From well & 10ft From PL
12/13/11 Reviewed Floor plans

Use "Serial" distribution on drainlines.
Divert stormwater away from Septic Areas.

INITIAL SITE SKETCH

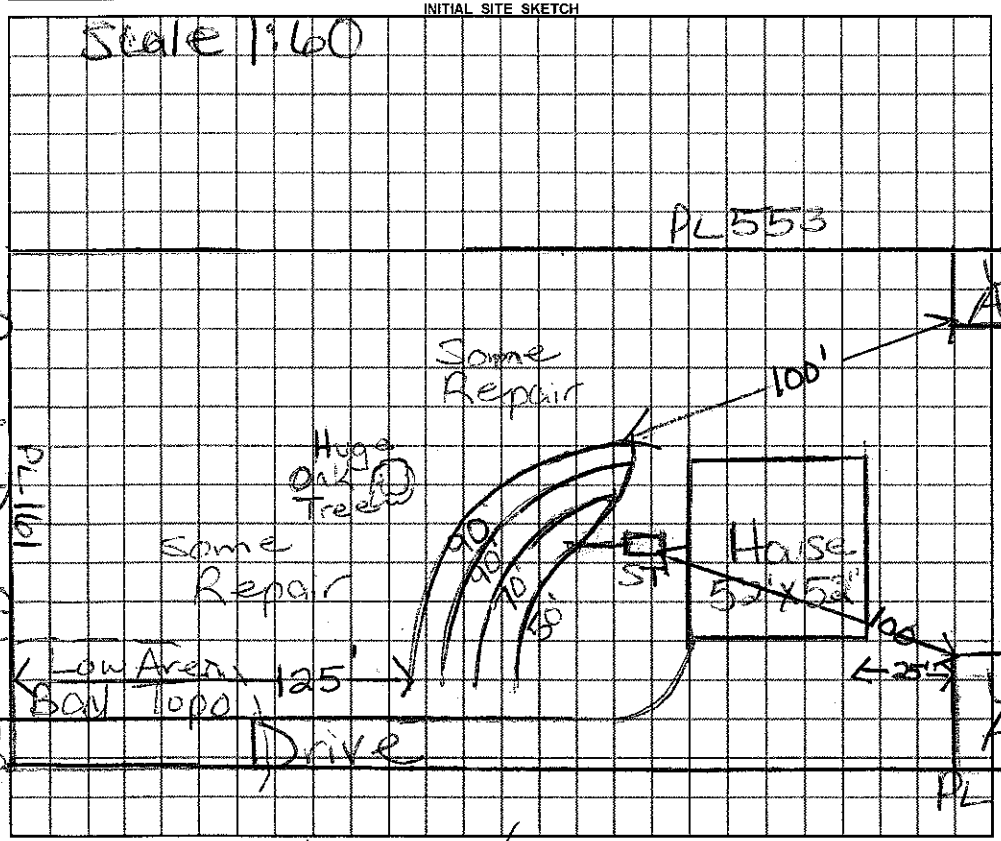

AS BUILT SKETCH

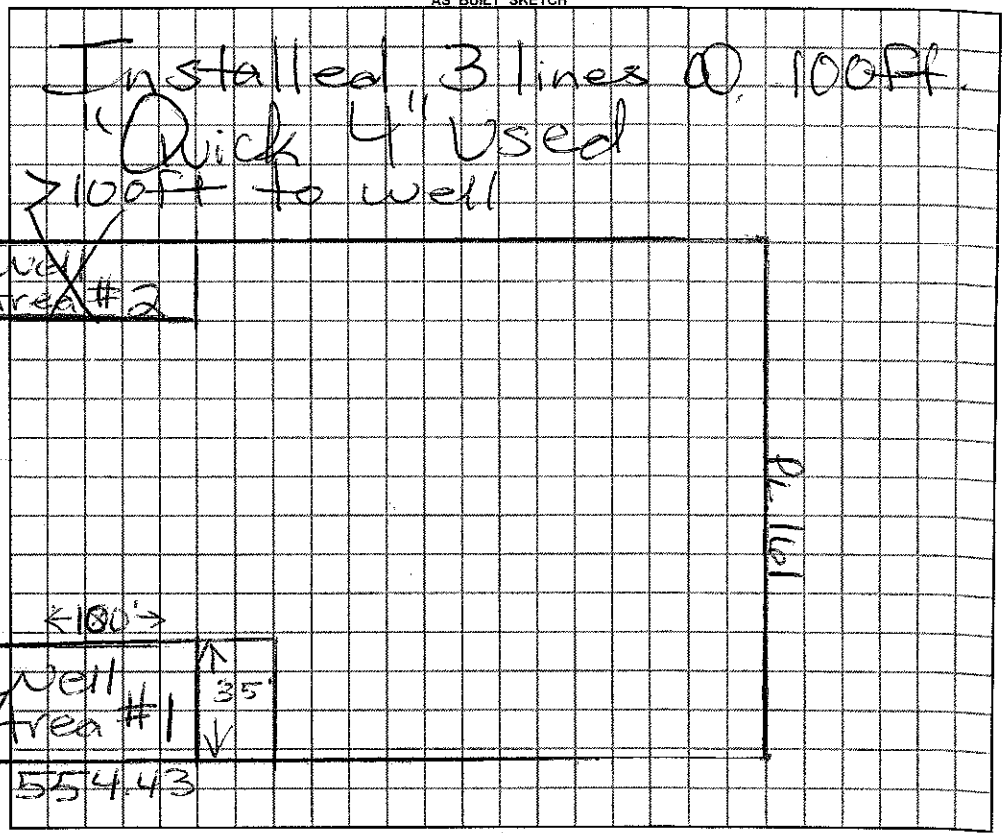

Permit can be suspended or revoked if any false information is supplied toward securing the permit / any unauthorized changes are made to the site / any unauthorized changes are made in the installation of the system.

☐ ***IMPROVEMENT PERMIT*** *with plat valid without expiration* ☐ ***IMPROVEMENT PERMIT*** *with ~~plat valid without expiration.~~ site plan valid 60 mo.* ☐ ***AUTHORIZATION TO CONSTRUCT*** valid for period equal to IMPROVEMENT PERMIT--not to exceed 60 mo.

Owner / Applicant Signature: Arnold Howard Date 12/13/2011 Installed by: A-1 Backhoe

IMPROVEMENT PERMIT by: Marie Hall REHS Date 12/12/2011 OPERATION PERMIT by: Marie Hall REHS Date 6/20/12

AUTHORIZATION TO CONSTRUCT by: Marie Hall REHS Date 12/13/2011 Existing System Inspected by: REHS Date

YOU SHOULD CONTACT A LOCATOR SERVICE PRIOR TO ANY EXCAVATION

White Copy – Environmental Health YELLOW COPY (Final) Owner / Applicant PINK COPY (Initial) Owner / Applicant