IREDELL COUNTY HEALTH DEPARTMENT

DOLLAR GENERAL — AZP

Statesville Office (704) 878-5305 — Mooresville Office (704) 660-3625

PERMIT # 2160054

IMPROVEMENT PERMIT / AUTHORIZATION TO CONSTRUCT / OPERATION PERMIT / EXISTING SYSTEM

PIN # 4658-76-0530

APPLICANT: VENTURE PROPERTIES VII, LLC — APPLICANT ADDRESS: PO Box 843, WILKSBORO, NC 28697

SITE ADDRESS: 2020 CHARLOTTE HWY. - MOORESVILLE — PHONE: — ALT. PHONE:

SITE DIRECTIONS: HWY 21, BESIDE FIRE DEPT

SUBDIVISION: — SECTION: — LOT # — LOT AREA: — DESIGN FLOW: 200 — L.T.A.R.: .25 (.125R)

Septic Tank 1000 (gal) STB 760 Date 4-26

~~Pump Tank~~ 1000 (gal) PT 700 Date 4-3

Pump Make — Model — Serial # —

Nitrification Fields 1 # Lines 4 @ 50' Linear Ft: 200'

Trench Width 36" Max. Trench Bottom Depth 24" Gravel Depth —

☒ New System ☐ Repair ☐ Expansion System Type: I II (III) IV V VI


Repair System Description: TS-1 DRIP (36" DEEP)

Maintenance Agreement Required: ☐ YES ☒ NO

☒ GRAVITY ☐ PRESSURE

☐ Residence ☒ Business ☐ Other ☒ Slab ☐ Crawl Space ☐ Basement w/plumbing ☐ Basement w/o plumbing

No. Bedrooms — No. Persons — No. Employees 8

Water Supply: ☒ Private ☐ Public ☐ Community

Comments / Conditions: ~~24~~ 24" TRENCH BOTTOM MAX ~~6~~ 6" COVER ~~X~~

DO NOT ISSUE AC UNTIL LOTS ARE RECORDED

MORE THAN 50' PER LINE SHOWN / ONLY USE 50'

~~X~~ MUST USE LOW FLOW FIXTURES AS SPECIFIED IN RULES ~~X~~

INITIAL SITE SKETCH

SEE PLAN FROM PERC

AS BUILT SKETCH

TRENCHES INSTALLED @ 24" AS DISCUSSED IN PRECON MEETING. SOIL NOTES SHOW NO ISSUES.

7-8-16 BA

Permit can be suspended or revoked if any false information is supplied toward securing the permit / any unauthorized changes are made to the site / any unauthorized changes are made in the installation of the system. **CONTACT A LOCATOR SERVICE PRIOR TO ANY EXCAVATION**


☐ **IMPROVEMENT PERMIT** *with plat valid without expiration.* ☒ **IMPROVEMENT PERMIT** *with site plan valid for 60 mos.* ☒ **AUTHORIZATION TO CONSTRUCT** *valid for period equal to IMPROVEMENT PERMIT--not to exceed 60 mo.*

Owner / Applicant Signature: — Date: 5/4/16 — Installed by: V & S SEPTIC SERVICE

IMPROVEMENT PERMIT by: BA — Date: 4-25-16 — OPERATION PERMIT by: BA — Date: 7-8-16

AUTHORIZATION TO CONSTRUCT by: BA — Date: 4-28-16 — Existing System Inspected by: — Date: —

Health Dept. Copy - WHITE Applicant (Final Approval) - YELLOW Applicant (Conditional Approval) - PINK

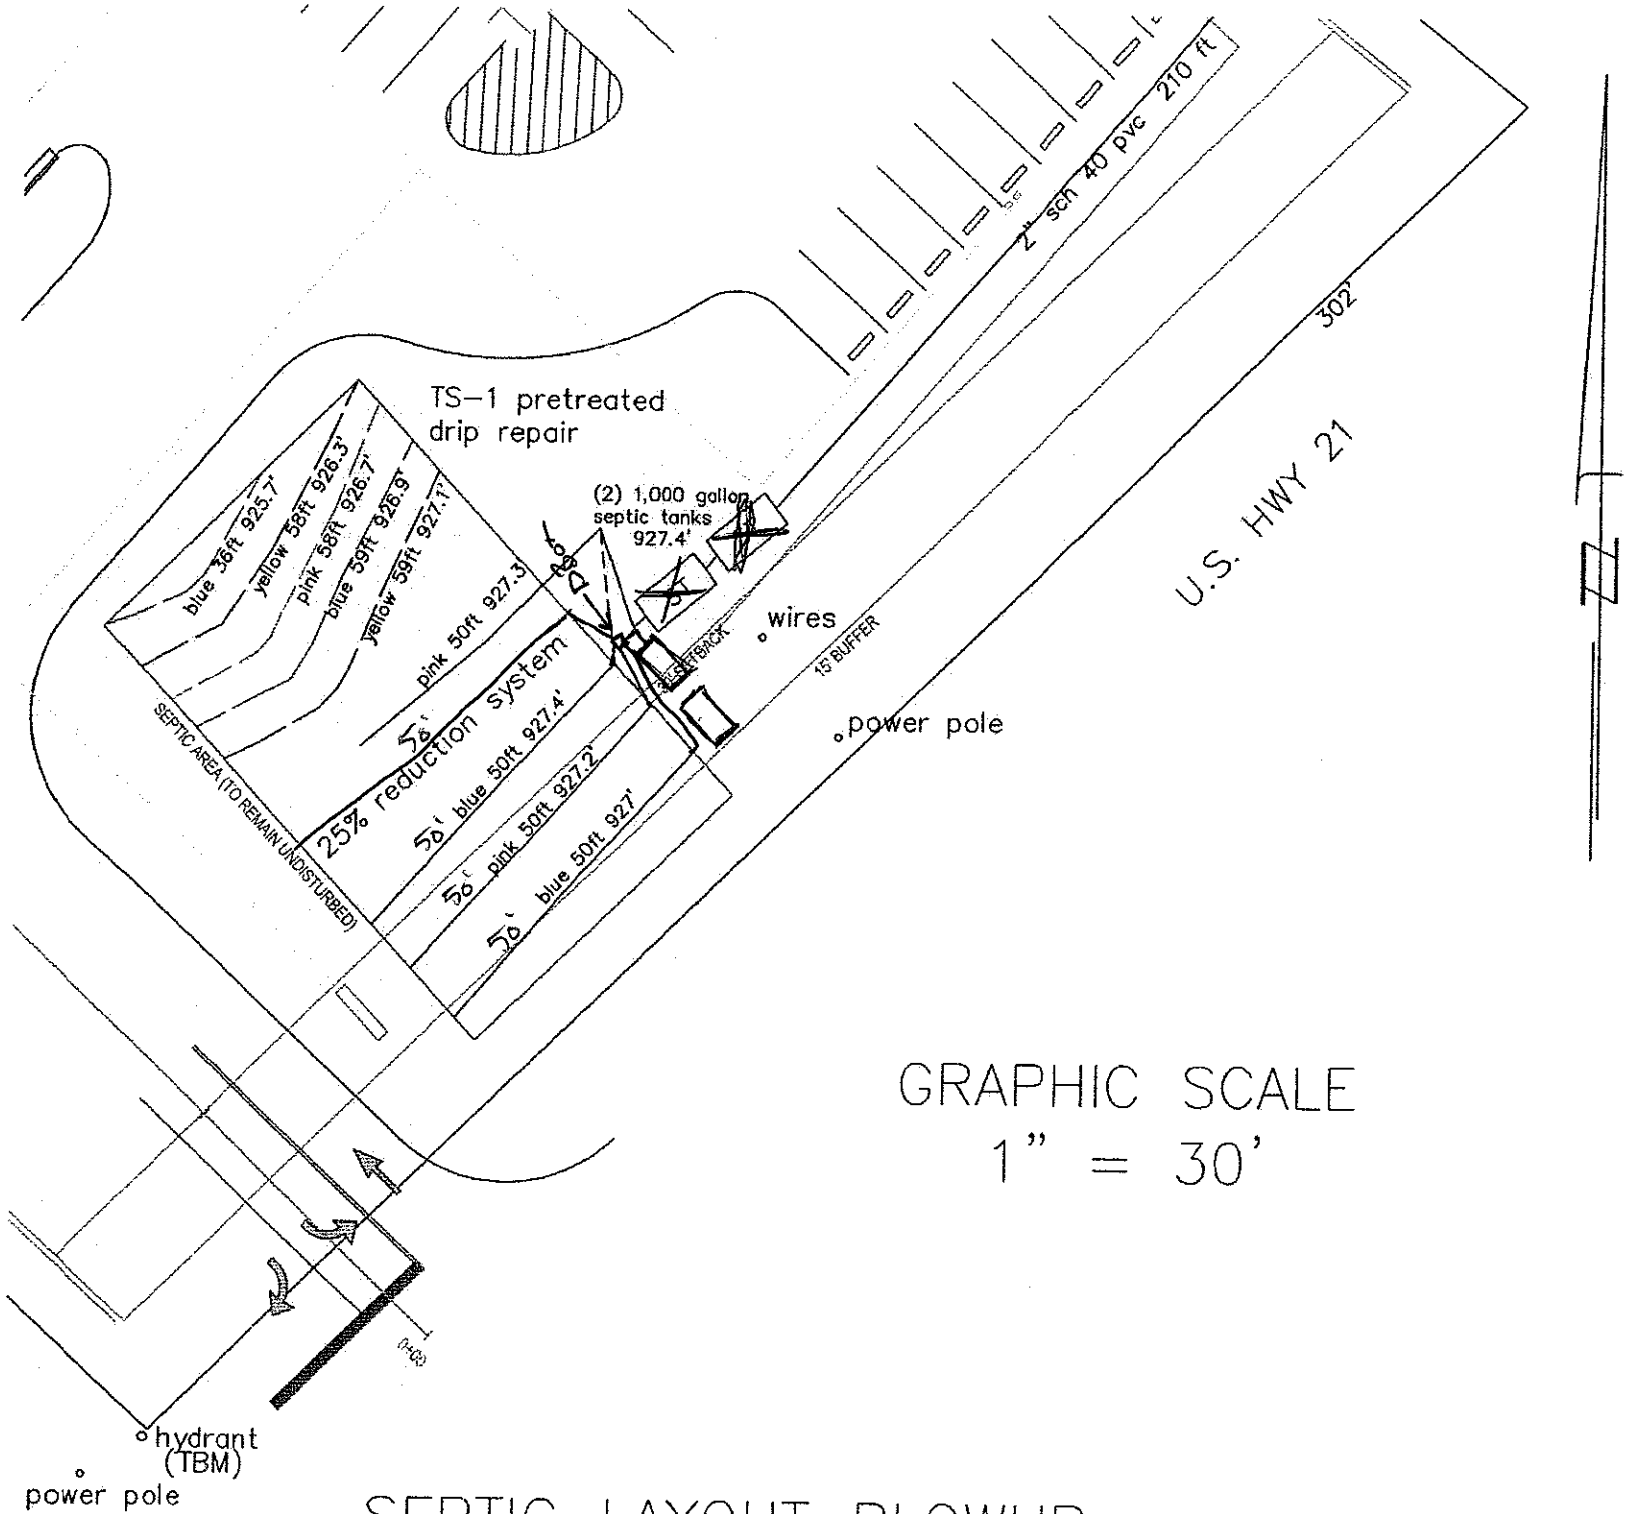

GRAPHIC SCALE
1" = 30'

SEPTIC LAYOUT BLOWUP