IREDELL COUNTY HEALTH DEPARTMENT

STATESVILLE 704-878-5305 MOORESVILLE 704-664-5281

IMPROVEMENT PERMIT / AUTHORIZATION TO CONSTRUCT / OPERATION PERMIT / EXISTING SYSTEM INSPECTION

PERMIT# Repair PIN# 4658 76 1250

OWNER OR CONTRACTOR Preston Cornelius PHONE: Business DATE 5/29/03

ADDRESS 2027 Charlotte HWY Mooresville NC 28117 Home 704-664-5460

LOCATION 115 N, on Lt before U-Point, Yellow Brick House

SUBDIVISION BLOCK / SECTION LOT LOT AREA 1.79 AC. SITE CLASS P5 DESIGN FLOW 360 L.T.A.R.

Septic Tank: Existing Gallons; STB Date

Pump Tank: 1000 Gallons; PT Date 4/12/03

Pump Make: ZOELLER Model N152A Serial No.

Nitrification Field: No Fields 1 Square Feet 1440 Linear Feet 480

No Lines 6@80' Trench Width 36" Max Trench Bottom Depth 24" Gravel Depth 12"

☒ New System ☐ Repair System Type: I, II, III, IV, V, VI

System Description:

Repair System Description: Pres. Man. Conventional

Maintenance Agreement Required: ☐ Yes ☒ No

☒ House/Mod. Home No. Bedrooms 3

☐ Mobile Home No. Bathrooms 1½

☐ Business No. Employees

☐ Other

☐ Slab ☐ Crawl Space ☐ Basement w/plumbing ☐ Basement wo/plumbing


Water Supply: ☒ Individual ☐ Public ☐ Community Existing

Comments:/Conditions:


HWY 21

Comments:/Conditions:

INITIAL SITE SKETCH

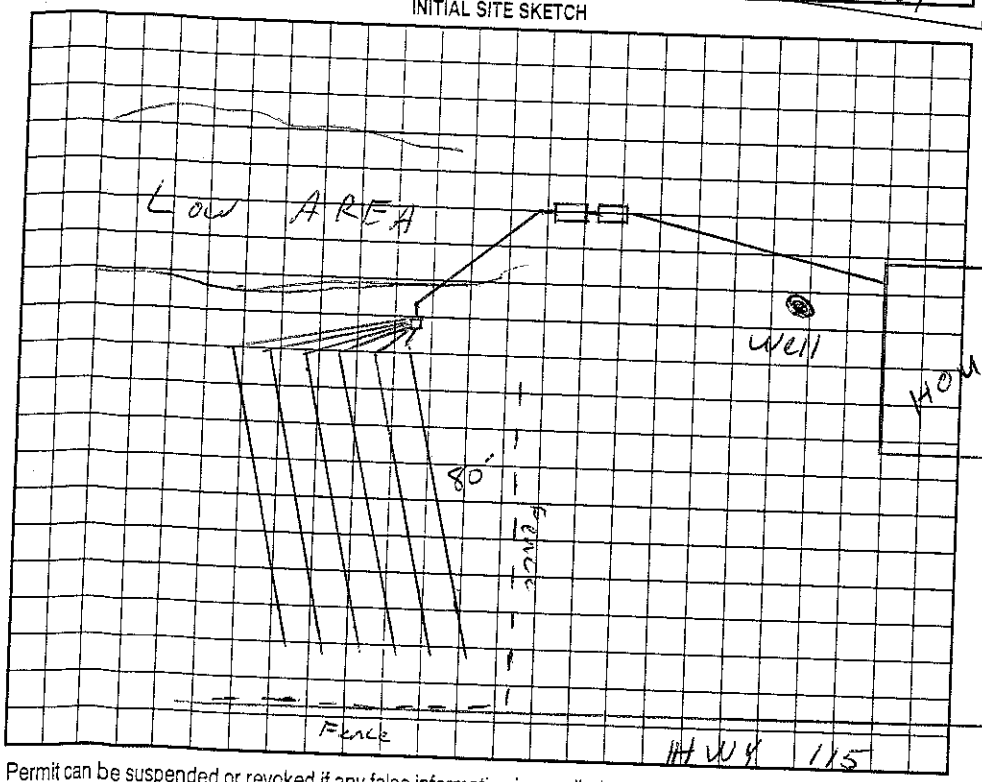

AS BUILT SKETCH

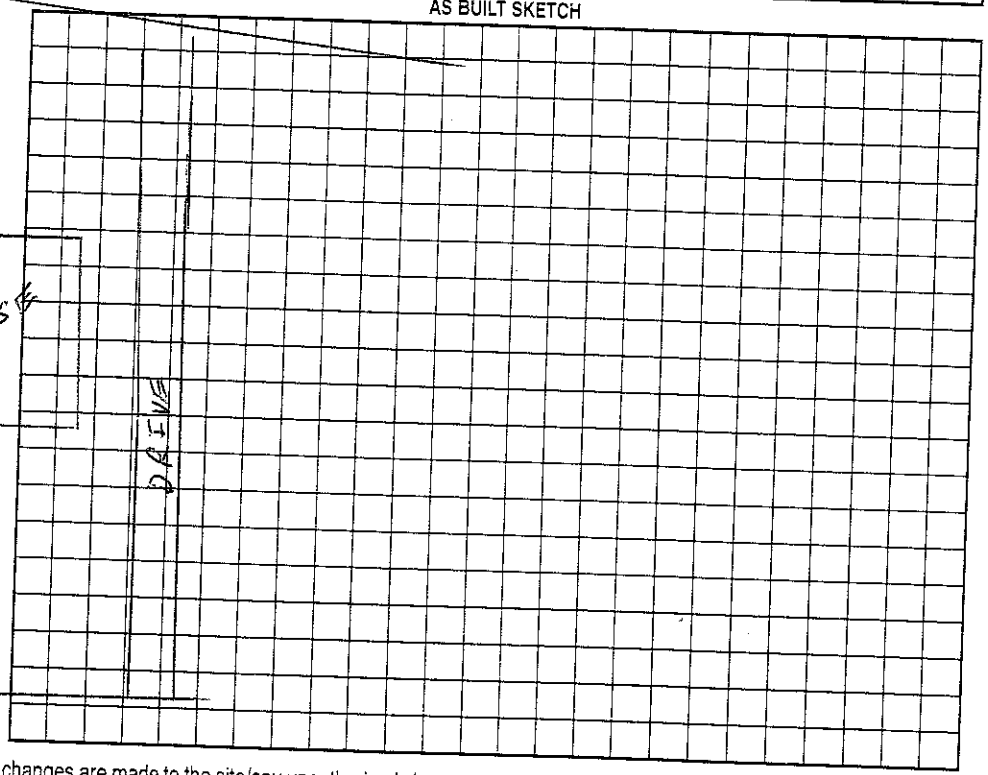

Permit can be suspended or revoked if any false information is supplied toward securing the permit/any unauthorized changes are made to the site/any unauthorized changes are made in the installation of the system. Improvement Permit with plat valid without expiration. Improvement Permit with site plan valid for sixty months. Authorization to Construct is valid for a period equal to that of Improvement Permit – not to exceed sixty months.

Signed: Mrs. Preston Cornelius date 6-5-03 Installed by: Bostian

Improvement Permit by: date 5/29/03 Operation Permit by: date 7/5/03

Authorization to Construct by: date 5/29/03 Existing System Inspection by: date

HEALTH DEPT. COPY: WHITE OWNER COPY (FINAL): YELLOW OWNER COPY (INITIAL): PINK