(10, 30)

IREDELL COUNTY HEALTH DEPARTMENT

STATESVILLE 704-878-5305 MOORESVILLE 704-664-5281

IMPROVEMENT PERMIT / AUTHORIZATION TO CONSTRUCT / OPERATION PERMIT / EXISTING SYSTEM INSP

PERMIT# 072200 PIN# 4658 76 2797 DATE 3/20/

OWNER OR CONTRACTOR JAMES E. SCHRONCE PHONE: Business _____ Home 664-3329

ADDRESS 221 SHINNVILLE RD MOORESVILLE 28115

LOCATION 21 N - TL JUST BEFORE JUCTION OF HWY 115 - AT FIRE DEPT.

SUBDIVISION — BLOCK / SECTION — LOT — LOT AREA 1.09 AC SITE CLASS. PS DESIGN FLOW 240GPD L.T.A.R. .30 PD/1992

Septic Tank: 1000 Gallons; STB 700 Date 1/12/98

Pump Tank: _____ Gallons; PT _____ Date _____

Pump Make: _____ Model _____ Serial No. _____

Nitrification Field: No Fields 1 Square Feet 840 Linear Feet 280

No Lines 4@70' Trench Width 36" Max Trench Bottom Depth 36" Gravel Depth 10"

☑ New System ☐ Repair System Type: I, II, III, IV, V, VI

System Description: GRAVITY CONVENTIONAL

Repair System Description: SAME

Maintenance Agreement Required: ☐ Yes ☑ No

☐ House/Mod. Home No. Bedrooms 2

☑ Mobile Home No. Bathrooms 2

☐ Business No. Employees ____

☐ Other _____


☐ Slab ☑ Crawl Space ☐ Basement w/plumbing ☐ Basement wo/plumbing

Water Supply: ☑ Individual ☐ Public ☐ Community


Comments:/Conditions:

Comments:/Conditions:

INITIAL SITE SKETCH

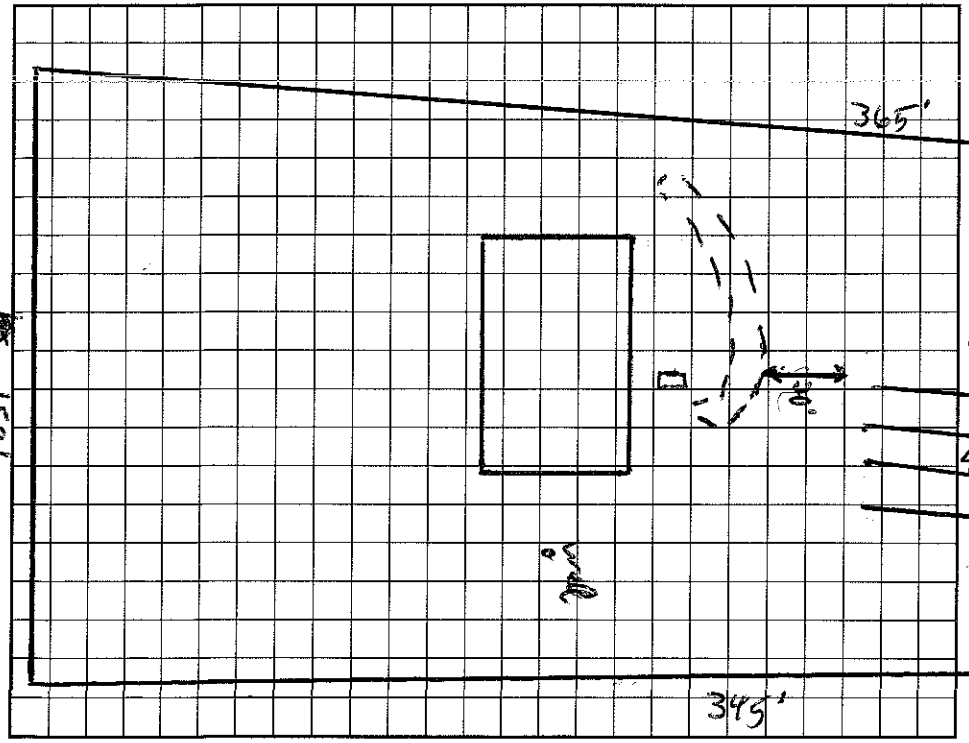

AS BUILT SKETCH

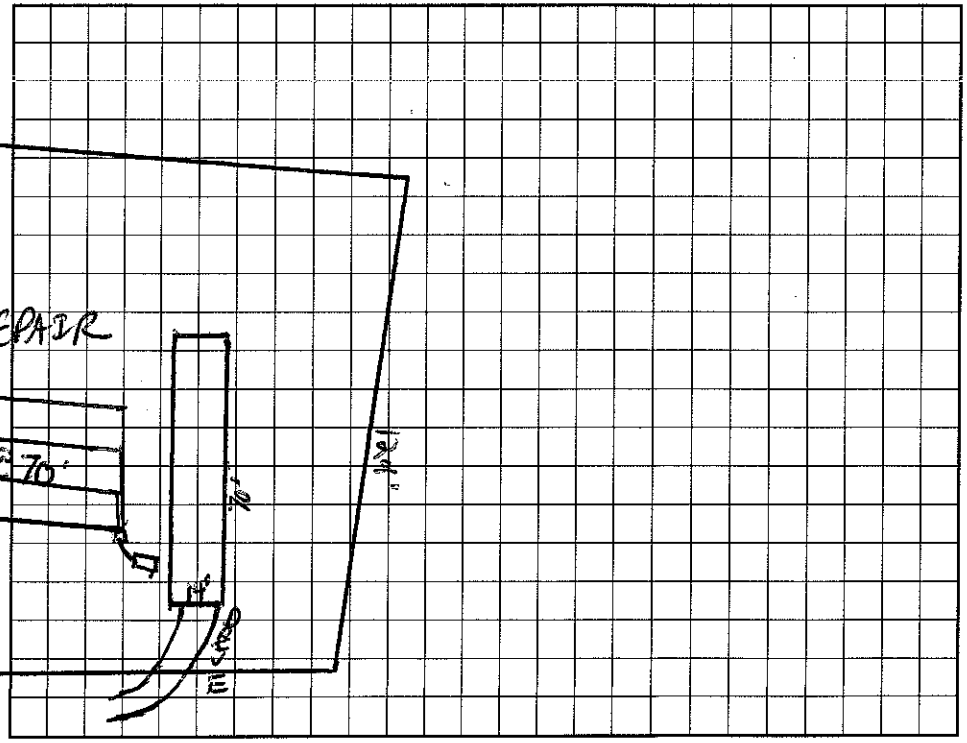

I understand that this permit can be suspended or revoked if any false information is supplied toward securing the permit/any unauthorized changes are made to the site/any unauthorized changes are made in the installation of the system. Improvement Permit with plat valid without expiration. Improvement Permit with site plan valid for sixty months. Authorization to Construct is valid for a period equal to that of Improvement Permit – not to exceed sixty months.

Signed: Jacqueline G. Schronce date 3-20 98 Installed by: LARRY POWELL

Improvement Permit by: C. Ray Tam date 3/20/98 Operation Permit by: _____ date _____

Authorization to Construct by: C. Ray Tam date 3/20/98 Existing System Inspection by: C. Ray Tam date 3/27/98

HEALTH DEPT. COPY: WHITE INSPECTION COPY (FINAL): GREEN OWNER COPY (FINAL): YELLOW INSPECTION COPY (INITIAL): PINK OWNER COPY (INITIAL): GOLD