IREDELL COUNTY HEALTH DEPARTMENT

STATESVILLE 704-878-5305 $130 MOORESVILLE 704-664-5281 9:30

IMPROVEMENT PERMIT / AUTHORIZATION TO CONSTRUCT / OPERATION PERMIT / EXISTING SYSTEM INSPECTION

PERMIT# 110794 PIN# ~~4658770452~~ 4658 76 5934 DATE 1-17-03

OWNER OR CONTRACTOR E Charles Dalton PHONE: Business 201-5537 Home 663-4541/660-1480

ADDRESS 1992 Charlotte Hwy Mooresville NC 28115

LOCATION Hwy 21 North just past "V" point on left behind Country Bargain

SUBDIVISION Dalton BLOCK / SECTION ____ LOT 2 LOT AREA .62 Acre SITE CLASS. PS DESIGN FLOW 360gpd J.T.A.R. .3

Septic Tank: 1000 Gallons; STB 1012 Date 5-5-02
Pump Tank: ____ Gallons; PT ____ Date ____
Pump Make: ____ Model ____ Serial No. ____
Nitrification Field: No Fields 1 Square Feet 900' Linear Feet 300'
No Lines 6 @ 50' Trench Width ____ Max Trench Bottom Depth ____ Gravel Depth ____

☒ New System ☐ Repair System Type: I, II, III, IV, V, VI
System Description: Gravity - 25% Reduction
Repair System Description: Panel Block
Maintenance Agreement Required: ☐ Yes ☐ No

☐ House/Mod. Home ☒ Mobile Home ☐ Business ☐ Other
No. Bedrooms 3 No. Bathrooms 2 No. Employees ____


☐ Slab ☐ Crawl Space ☐ Basement w/plumbing ☐ Basement wo/plumbing

Water Supply: ☒ Individual ☐ Public ☐ Community


Comments:/Conditions: Keep Septic System at least 10' from PL & 100' to Well

Comments:/Conditions: ☆ Okay to install in 4-75' lines if it will fit on Contour. Yellow filter & tank marker present

INITIAL SITE SKETCH Scale 1:60

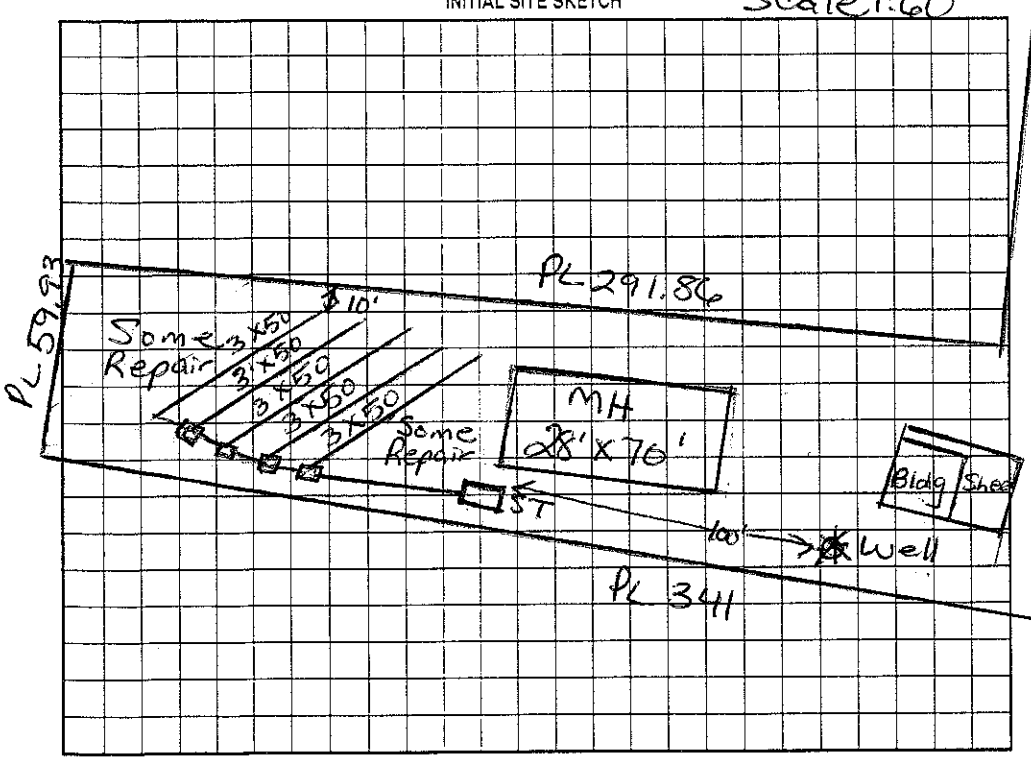

AS BUILT SKETCH

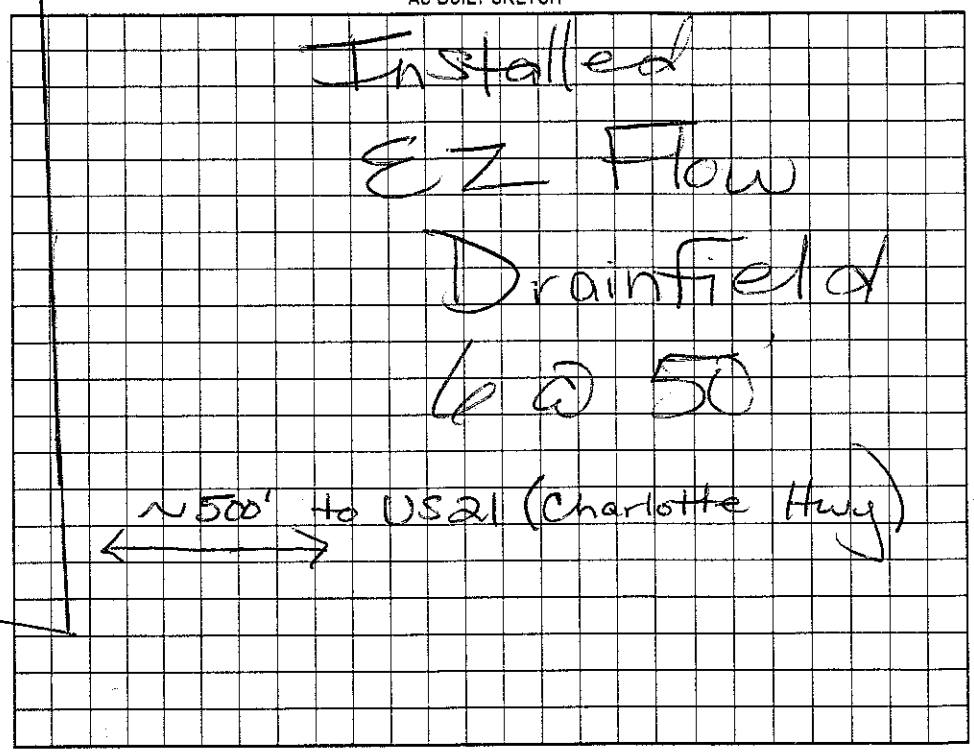

Permit can be suspended or revoked if any false information is supplied toward securing the permit/any unauthorized changes are made to the site/any unauthorized changes are made in the installation of the system. Improvement Permit with plat valid without expiration. Improvement Permit with site plan valid for sixty months. Authorization to Construct is valid for a period equal to that of Improvement Permit – not to exceed sixty months.

Signed: E. Charles Dalton date ____

Improvement Permit by: Maria H. Dotson R.S. date 1/17/03

Authorization to Construct by: Maria H. Dotson R.S. date 1/17/03

Installed by: A-1 Backhoe

Operation Permit by: Maria H. Dotson R.S. date 3/4/03

Existing System Inspection by: ____ date ____

HEALTH DEPT. COPY: WHITE OWNER COPY (FINAL): YELLOW OWNER COPY (INITIAL): PINK