1:30

IREDELL COUNTY HEALTH DEPARTMENT

STATESVILLE 704-878-5305 MOORESVILLE 704-664-5281

IMPROVEMENT PERMIT / AUTHORIZATION TO CONSTRUCT / OPERATION PERMIT / EXISTING SYSTEM INSPECTION

PERMIT# REPAIR PIN# REPAIR 4658-76-6499 DATE 5/7/01

OWNER OR CONTRACTOR MARY OVERCASH PHONE: Business Home

ADDRESS 2005 CHARLOTTE HWY MOORESVILLE

LOCATION HWY 115 N - ACROSS FROM ZIP & GO @ V-POINT 2005 Statesville Hwy

SUBDIVISION BLOCK / SECTION LOT LOT AREA .99Ac SITE CLASS. PS DESIGN FLOW 360 GPD L.T.A.R.

Septic Tank: EXISTING Gallons; STB Date

Pump Tank: " Gallons; PT Date

Pump Make: Model Serial No.

Nitrification Field: No Fields 1 Square Feet 300 Linear Feet 100

No Lines 1@100' Trench Width 36" Max Trench Bottom Depth AS NEEDED Gravel Depth

☐ New System ☑ Repair System Type: I, II, III, IV, V, VI

System Description:

Repair System Description: PUMP CHAMBERS

Maintenance Agreement Required: ☐ Yes ☑ No

☑ House/Mod. Home No. Bedrooms 3

☐ Mobile Home No. Bathrooms 2

☐ Business No. Employees

☐ Other

☐ Slab ☑ Crawl Space ☐ Basement w/plumbing ☐ Basement wo/plumbing


Water Supply: ☑ Individual ☐ Public ☐ Community

Comments:/Conditions:


(2nd REPAIR)

Comments:/Conditions: Opened up all lines equally, didn't reset pressure.

INITIAL SITE SKETCH

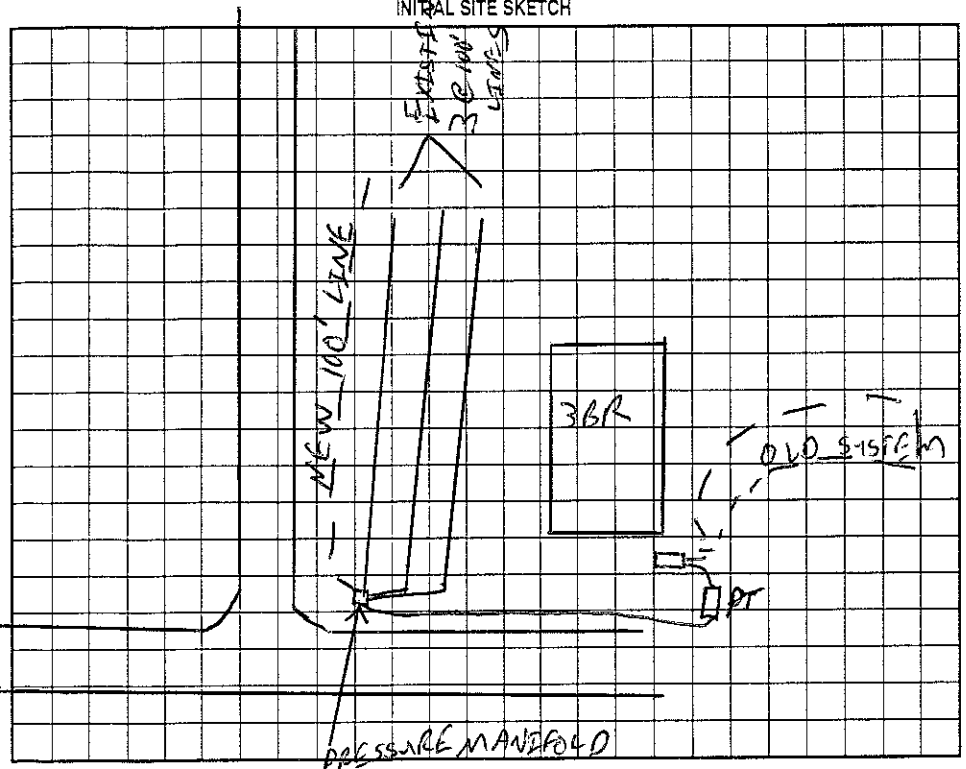

AS BUILT SKETCH

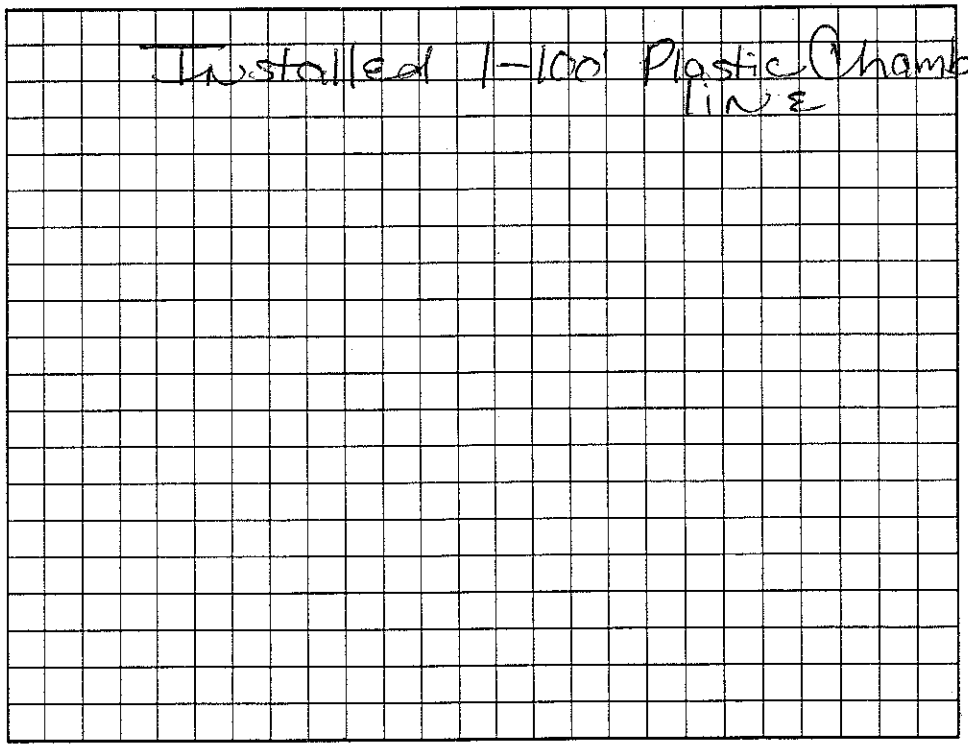

Permit can be suspended or revoked if any false information is supplied toward securing the permit/any unauthorized changes are made to the site/any unauthorized changes are made in the installation of the system. Improvement Permit with plat valid without expiration. Improvement Permit with site plan valid for sixty months. Authorization to Construct is valid for a period equal to that of Improvement Permit – not to exceed sixty months.

Signed: date

Improvement Permit by: C. Hyatt RS date 5/7/01

Authorization to Construct by: C. Hyatt RS date 5/7/01

Installed by: Wayne Chontz

Operation Permit by: Marshall Dotson RS date 5/8/2001

Existing System Inspection by: date

HEALTH DEPT. COPY: WHITE OWNER COPY (FINAL): YELLOW OWNER COPY (INITIAL): PINK