IREDELL COUNTY HEALTH DEPARTMENT

STATESVILLE 704-878-5305 MOORESVILLE 704-664-5281

IMPROVEMENT PERMIT / AUTHORIZATION TO CONSTRUCT / OPERATION PERMIT / EXISTING SYSTEM INSPECT

PERMIT# 072897 PIN# ~~4658702927 PT~~ 4658770999 DATE 5/1/98

OWNER OR CONTRACTOR JAMES SCHRONCE PHONE: Business _____ Home 664-3329

ADDRESS 221 SHINVILLE RD MOORESVILLE NC 28115

LOCATION HWY 21 N. BEFORE SCT OF 115 ON LT AT FIRE DEPT.

SUBDIVISION _____ BLOCK / SECTION — LOT — LOT AREA — SITE CLASS. PS DESIGN FLOW 240 GPD L.T.A.R. .36 GPD/FT²

Septic Tank: 1000 Gallons; STB 794 Date 3-4-98

Pump Tank: _____ Gallons; PT _____ Date _____

Pump Make: _____ Model _____ Serial No. _____

Nitrification Field: No Fields 1 Square Feet 740 Linear Feet 280

No Lines 4@70' Trench Width 36" Max Trench Bottom Depth 36" Gravel Depth 12"

☑ New System ☐ Repair System Type: I (II) III, IV, V, VI

System Description: GRAVITY CONVENTIONAL

Repair System Description: CONVENTIONAL

Maintenance Agreement Required: ☐ Yes ☑ No

☐ House/Mod. Home ☑ Mobile Home ☐ Business ☐ Other

No. Bedrooms 3 No. Bathrooms 2 No. Employees ____


☐ Slab ☑ Crawl Space ☐ Basement w/plumbing ☐ Basement wo/plumbing

Water Supply: ☑ Individual ☐ Public ☐ Community FROM NEIGHBOR


Comments:/Conditions:

Comments:/Conditions: Water will come from the existing trailer >100' Separation MH on site but not set yet.

INITIAL SITE SKETCH 1"=100'

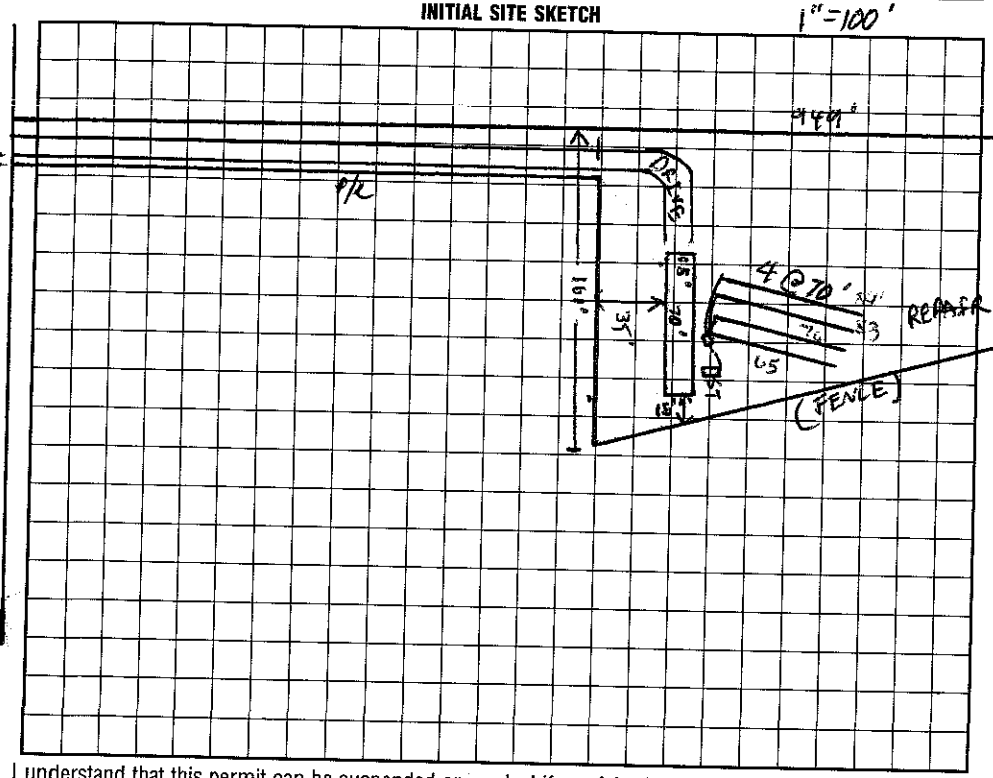

AS BUILT SKETCH

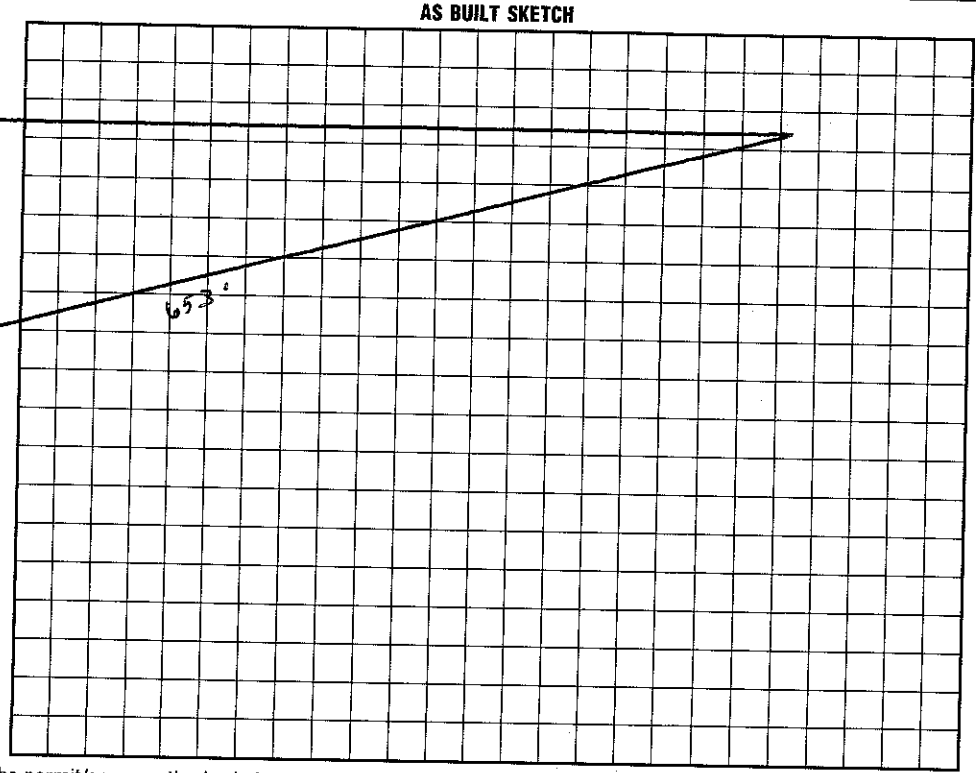

I understand that this permit can be suspended or revoked if any false information is supplied toward securing the permit/any unauthorized changes are made to the site/any unauthorized changes are made in the installation of the system. Improvement Permit with plat valid without expiration. Improvement Permit with site plan valid for sixty months. Authorization to Construct is valid for a period equal to that of Improvement Permit – not to exceed sixty months.

Signed: Jacqueline V. Schronce date 5-4-98

Improvement Permit by: C. [illegible] RS date 5/1/98

Authorization to Construct by: C. [illegible] RS date 5/1/98

Installed by: Powell Backhoe Service

Operation Permit by: [illegible] date 5/13/98

Existing System Inspection by: [illegible] date 5/13/98

HEALTH DEPT. COPY: WHITE INSPECTION COPY (FINAL): GREEN OWNER COPY (FINAL): YELLOW INSPECTION COPY (INITIAL): PINK OWNER COPY (INITIAL): GOLD