IREDELL COUNTY HEALTH DEPARTMENT

STATESVILLE 704-878-5305 MOORESVILLE 704-664-5281

IMPROVEMENT PERMIT / AUTHORIZATION TO CONSTRUCT / OPERATION PERMIT / EXISTING SYSTEM INSPECTION

PERMIT# 105657 PIN# 4658771358 4658773272 DATE 5/2/2002

OWNER OR CONTRACTOR Charles & Mary Dalton PHONE: Business 663-4541 Home

ADDRESS 1994 Charlotte Hwy Mooresville NC 28115

LOCATION Hwy 21 N just past junction with Hwy 115 on left behind Country Bargains

SUBDIVISION BLOCK SECTION LOT LOT AREA SITE CLASS PS DESIGN FLOW 240gpd L.T.A.R.

Septic Tank: Existing Gallons; STB Date

Pump Tank: Gallons; PT Date

Pump Make: Model Serial No.

Nitrification Field: No Fields Square Feet Linear Feet

No Lines Trench Width Existing Max Trench Bottom Depth Gravel Depth

☐ New System ☐ Repair System Type: I II III IV V VI

System Description: Existing Gravity Conv.

Repair System Description:

Maintenance Agreement Required: ☐ Yes ☐ No

☐ House/Mod. Home No. Bedrooms 2

☒ Mobile Home No. Bathrooms 2

☐ Business No. Employees

☐ Other


☐ Slab ☒ Crawl Space ☐ Basement w/plumbing ☐ Basement wo/plumbing

Water Supply:
- ☒ Individual Shared
- ☐ Public
- ☐ Community

Comments:/Conditions: Existing Septic System appears to be functioning okay at time of inspection, No problems noticed.

Comments:/Conditions: * Keep new MH at least 5' from Septic System. Originally installed in 1990.

INITIAL SITE SKETCH Not to Scale

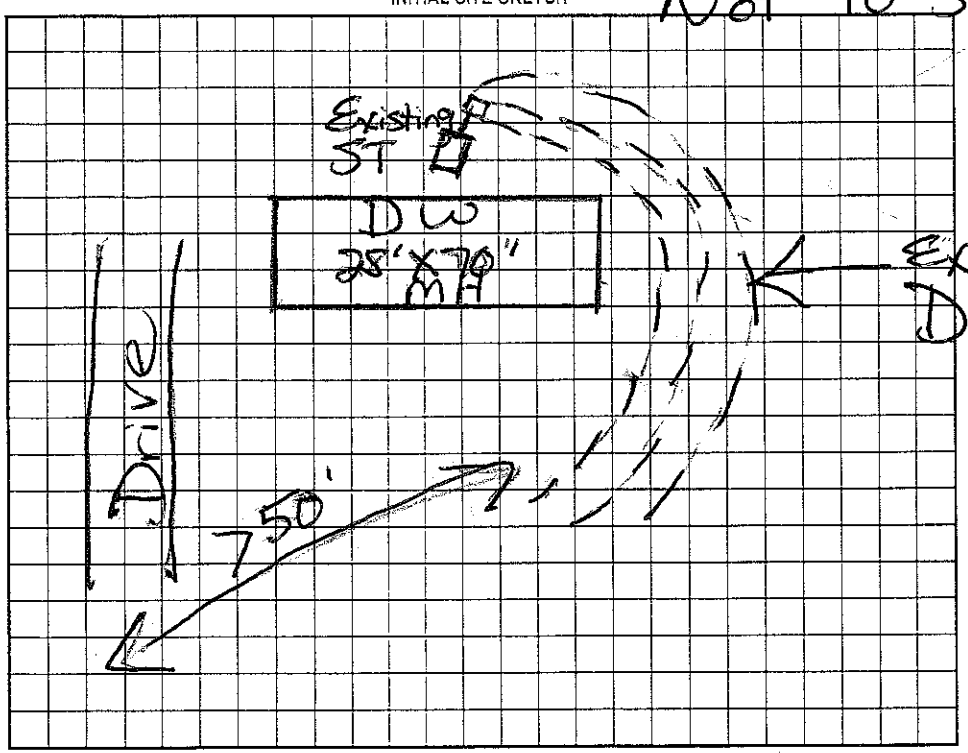

AS BUILT SKETCH

Permit can be suspended or revoked if any false information is supplied toward securing the permit/any unauthorized changes are made to the site/any unauthorized changes are made in the installation of the system. Improvement Permit with plat valid without expiration. Improvement Permit with site plan valid for sixty months. Authorization to Construct is valid for a period equal to that of Improvement Permit – not to exceed sixty months.

Signed: X Mary J. Dalton date Installed by:

Improvement Permit by: Maria H.H. Dotson R.S. date 5/2/2002 Operation Permit by: date

Authorization to Construct by: date Existing System Inspection by: Maria H.H. Dotson R.S. date 5/2/2002

HEALTH DEPT. COPY: WHITE OWNER COPY (FINAL): YELLOW OWNER COPY (INITIAL): PINK