IREDELL COUNTY HEALTH DEPARTMENT

STATESVILLE 704-878-5305 MOORESVILLE 704-663-281

10:00

IMPROVEMENT PERMIT / AUTHORIZATION TO CONSTRUCT / OPERATION PERMIT / EXISTING SYSTEM INSPECTION

PERMIT# No PIN# 4658 77 9075 DATE 1/24/01

OWNER OR CONTRACTOR Tim + Lenna Rust PHONE: Business Home 663-1655

ADDRESS 1979 Charlotte Hwy. Mooresville, NC. 28115

LOCATION 115 72 IN TR before Shimmelle Rd. onto gravel drive to greenhouse in trees

SUBDIVISION No BLOCK / SECTION LOT No LOT AREA 1.34 Ac SITE CLASS. PS DESIGN FLOW 360 L.T.A.R. .3

Septic Tank: EXISTING Gallons; STB Date

Pump Tank: 1000 Gallons; PT 27 Date 1/9/01

Pump Make: HYDROMATIC Model SK50A1 Serial No. 1/01

Nitrification Field: No Fields 1 Square Feet 900 Linear Feet 300

No Lines 3@100' Trench Width 3' Max Trench Bottom Depth 3' ~~Gravel Depth~~ SAND.

☐ New System ☒ Repair System Type: I, II, (III), IV, V, VI

System Description: Press. Man to 25% Reduced

Repair System Description:

Maintenance Agreement Required: ☐ Yes ☒ No

☒ House/Mod. Home No. Bedrooms 3

☐ Mobile Home No. Bathrooms 1

☐ Business No. Employees

☐ Other

☐ Slab ☒ Crawl Space ☐ Basement w/plumbing ☐ Basement wo/plumbing


Water Supply: ☒ Individual ☐ Public ☐ Community

Comments:/Conditions: Existing drainfield cut out of ground by grading operation around this property.

Comments:/Conditions:

installed as drawn on AC.

INITIAL SITE SKETCH

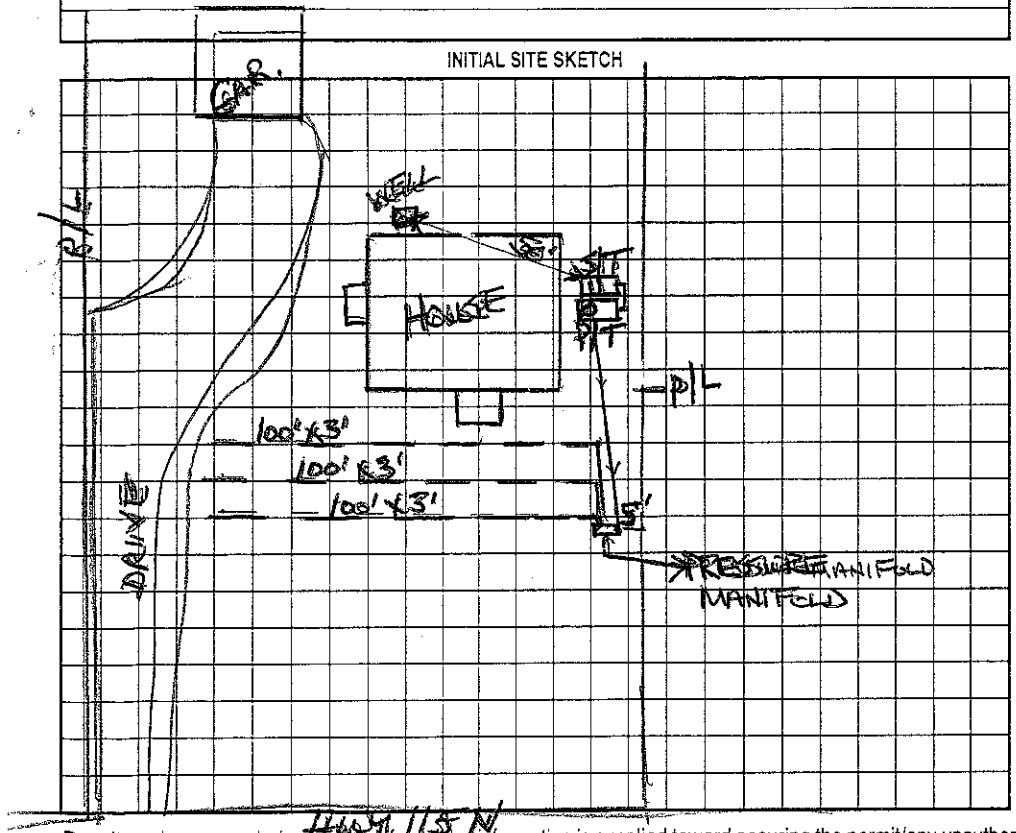

AS BUILT SKETCH

Permit can be suspended or revoked if any false information is supplied toward securing the permit/any unauthorized changes are made to the site/any unauthorized changes are made in the installation of the system. Improvement Permit with plat valid without expiration. Improvement Permit with site plan valid for sixty months. Authorization to Construct is valid for a period equal to that of Improvement Permit – not to exceed sixty months.

Signed: Lenna Rust date 1-26-2001

Improvement Permit by: Wesley Sparks R.S. date 1/24/01

Authorization to Construct by: Wesley Sparks R.S. date 1/24/01

Installed by: Orbison Const Co.

Operation Permit by: Wesley Sparks R.S. date 2/27/01

Existing System Inspection by: date

HEALTH DEPT. COPY: WHITE OWNER COPY (FINAL): YELLOW OWNER COPY (INITIAL): PINK