IREDELL COUNTY HEALTH DEPARTMENT

Statesville Office (704) 878-5305 Mooresville Office (704) 660-3625 PERMIT #

IMPROVEMENT PERMIT / AUTHORIZATION TO CONSTRUCT / OPERATION PERMIT / EXISTING SYSTEM

PIN # 4658797550

APPLICANT: Travis Donaldson APPLICANT ADDRESS: 1860 Charlotte Hwy Mooresville, NC

SITE ADDRESS: 1860 Charlotte Hwy Mooresville, NC PHONE: ALT PHONE:

SITE DIRECTIONS: Charlotte Hwy (US 21) North past Shinnville before Belk Rd on left

SUBDIVISION: SECTION: LOT # LOT AREA: DESIGN FLOW: 240gpd L.T.A.R.:

Septic Tank Exist (gal) STB Date
Pump Tank (gal) PT Date
Pump Make Model Serial #
Nitrification Fields # Lines Linear Ft:
Trench Width Max. Trench Bottom Depth Gravel Depth


☐ New System ☐ Repair ☐ Expansion System Type: I II III IV V VI
System Description: Exist. Gravity Conventional
Repair System Description: Lot developed prior to 1983
Maintenance Agreement Required: ☐ YES ☒ NO
☒ GRAVITY ☐ PRESSURE

☒ Residence No. Bedrooms 2
☐ Business No. Persons
☐ Other No. Employees
☐ Slab ☐ Crawl Space
☐ Basement w/plumbing ☐ Basement w/o plumbing

Water Supply: ☒ Private ☐ Public ☐ Community

Comments / Conditions:

INITIAL SITE SKETCH

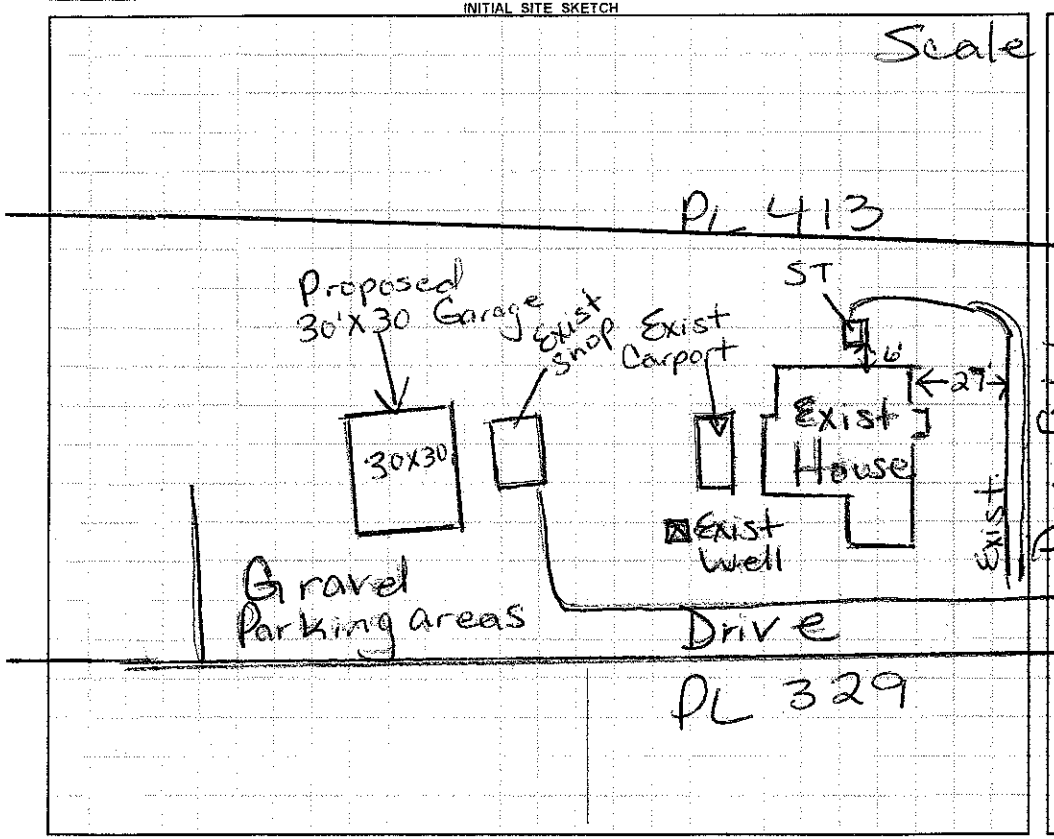

AS BUILT SKETCH

Permit can be suspended or revoked if any false information is supplied toward securing the permit / any unauthorized changes are made to the site / any unauthor

☐ **IMPROVEMENT PERMIT** ***with plat*** *valid without expiration.* ☐ **IMPROVEMENT PERMIT** ***with site plan*** *valid for 60 mos.* ☐ **EXCAVATION** *valid 60 mo.*

☐ Location of the proposed Garage addition does not appear to impact the existing on-site septic system.**NOTE: Any Building must be 5ft from Septic System & 25ft from well

Owner / Applicant Signature: Date: Installed by:

IMPROVEMENT PERMIT by: Date: OPERATION PERMI

AUTHORIZATION TO CONSTRUCT by: Date: Existing System In

Maria Nelson REHS
Date: 3/8/2013
ICHD-Environmental Health Division

Health Dept. Copy - WHITE Applicant (Final Approval) - YELLOW Applicant (Conditional Approval) - PINK