4658 84 2288

IREDELL COUNTY HEALTH DEPARTMENT

(SEPTIC TANK) IMPROVEMENTS PERMIT AND CERTIFICATE OF COMPLETION

(Ground Absorption Sewage Disposal System -- G. S. Chapter 130-Article 13C)

OWNER OR CONTRACTOR Roger Ketchie DATE 3/17/88 PERMIT NO. _____

PHONE: Business _____ Home 664-1162

LOCATION 115N Pass Mazeppa Rd. 1/4 mile on left

SUBDIVISION NAME _____ S. R. No. _____

LOT NO. _____ SECTION OR BLOCK NO. _____

House (✓) Mobile Home ( ) Business ( ) Other _____

No. Bedrooms 3 No. Bathrooms 2

Garbage Disposal Unit	Yes ( )	No (✓)
Auto. Dishwasher	Yes (✓)	No ( )
Auto. Wash. Machine	Yes (✓)	No ( )
Site Suitable	Yes (✓)	No ( )

Lot Area _____

Character & Porosity of Soil existing


Percolation Rate _____

Topography _____

Depth to Water Table _____

Rock or other impervious formations _____

_____ Basement with Plumbing _____ Basement without Plumbing ✓ No Basement

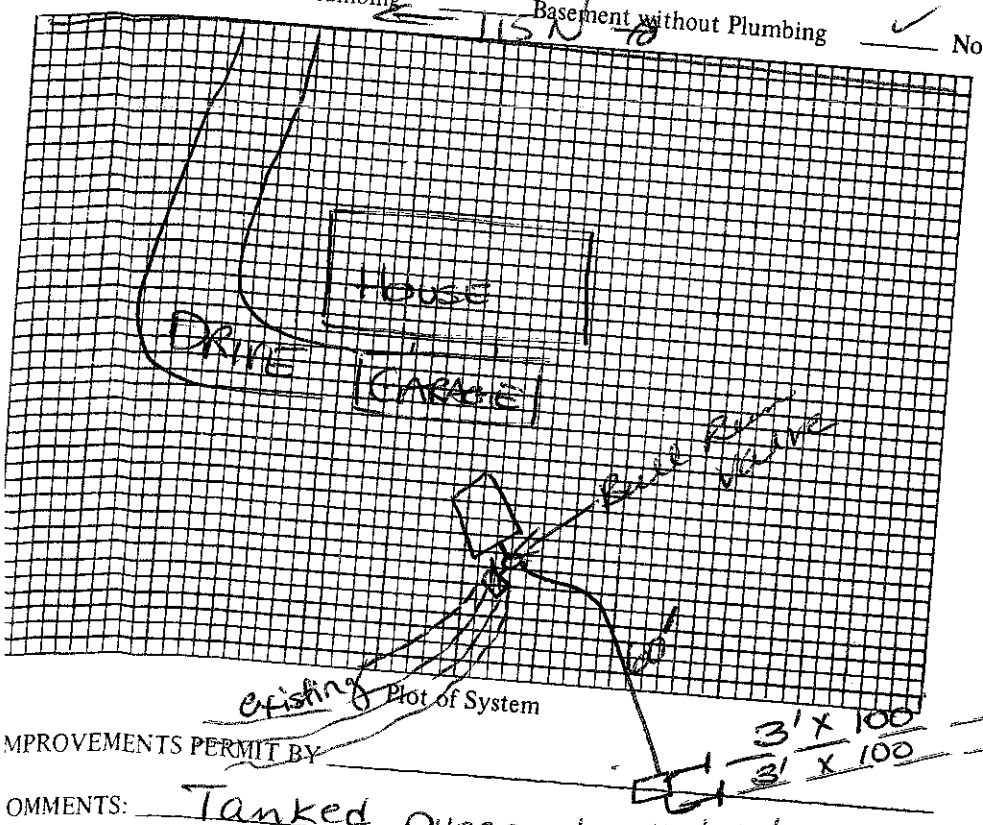

Size of Tank 1000 Gals.

Nitrification Field:

No. of Lines 2

Sq. Ft. 600 Linear Ft. 200

Depth of Stone in Lines 12"

Water Supply: Individual (✓)

Public ( )

Installed by Wayne Orbinson

I understand and agree to install septic tank system as specified on this Improvements Permit.

Signed: _____

IMPROVEMENTS PERMIT BY _____

COMMENTS: Tanked pumped 3/17/88. Don't recommend gardening over lines.

CERTIFICATE OF COMPLETION BY Andrew C. Owen

EXISTING SYSTEM CHECKED BY: _____ DATE 3/17/88

CONSTRUCTION MUST COMPLY WITH ALL OTHER APPLICABLE STATE AND LOCAL REGULATIONS.

Permit is VOID if any unauthorized changes are made in installation of system and/or if any false information is supplied in making Improvements Permit. DATE _____

Health Dept. Copy: White Inspection Dept. Copy: Yellow Sanitarian's Copy: Pink Owner's Copy: Gold

IREDELL COUNTY HEALTH DEPARTMENT

(SEPTIC TANK) IMPROVEMENTS PERMIT AND CERTIFICATE OF COMPLETION
(Ground Absorption Sewage Disposal System -- G. S. Chapter 130-Article 13C)

OWNER OR CONTRACTOR ROGER KETCHIE DATE 3/2/88 PERMIT NO.

PHONE: Business Home 664-1162

LOCATION 115N Pass Mazeppa Rd. 1/4 mile on left. S. R. No.

SUBDIVISION NAME LOT NO. SECTION OR BLOCK NO.

House (✓) Mobile Home ( ) Business ( ) Other


No. Bedrooms 3 No. Bathrooms 2

Garbage Disposal Unit	Yes	( )	No	(✓)
Auto. Dishwasher	Yes	(✓)	No	( )
Auto. Wash. Machine	Yes	(✓)	No	( )
Site Suitable EXISTING	Yes	( )	No	( )

Character & Porosity of Soil existing
Percolation Rate ↓
Topography 2%
Depth to Water Table (4'+) existing
Rock or other impervious formations none observed SURFACE

Lot Area

___ Basement with Plumbing ← Basement without Plumbing ✓ No Basement

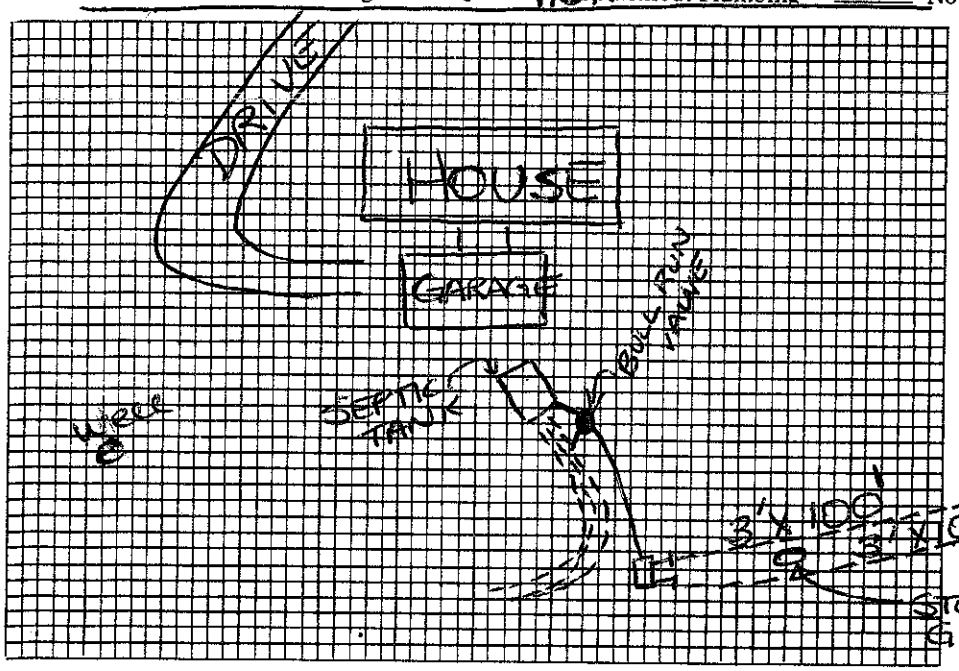

Plot of System

Size of Tank 1000 PRECAST Gals.
Nitrification Field:
No. of Lines 2
Sq. Ft. 600 Linear Ft. 200
Depth of Stone in Lines 12"
Water Supply: Individual (✓)
Public ( )

Installed by

I understand and agree to install septic tank system as specified on this Improvements Permit.

Signed: Roger W. Ketchie

10 ↔ PROPERTY

NEIGHBORS WELL ↓ 120'

IMPROVEMENTS PERMIT BY Andrew C. Price

COMMENTS: RECOMMEND PUMPING TANK.
CHECK "TEE" and replace if need be.
BULL RUN TO OLD LINE AND NEW LINE. KEEP NEW REPAIR SHALLOW (30" to bottom of ditch.) Add WASHER LINE TO SYSTEM.

CERTIFICATE OF COMPLETION BY DATE

EXISTING SYSTEM CHECKED BY: DATE

CONSTRUCTION MUST COMPLY WITH ALL OTHER APPLICABLE STATE AND LOCAL REGULATIONS.

Permit is VOID if any unauthorized changes are made in installation of system and/or if any false information is supplied in making Improvements Permit.

Health Dept. Copy: White Inspection Dept. Copy: Yellow Sanitarian's Copy: Pink Owner's Copy: Gold

IREDELL COUNTY HEALTH DEPARTMENT

Statesville Phone TR 3-7271 Mooresville Phone NO 3-1271

PERMIT TO INSTALL SEPTIC TANK

Permit NO. _____ Permit Date 19 April 1968

Owner Roger Kodak Address Mooresville

Installed By Hoyle H. Owens Address Mooresville


Location of Property above Roy Hollifield Plumbing

Tank		Capacity		Length of Lines		Fixtures	
Block	( )	1000	(✓)	225'	( )	No. of Baths	( )
Precast	(✓)	1250	( )	250'	( )	Dishwasher	( )
		1500	( )	Other _____		Garbage Grdr.	( )
		Other _____				Other _____	

NOTIFY HEALTH DEPARTMENT AT LEAST EIGHT HOURS BEFORE TANK IS TO BE INSPECTED.

Final Inspection 19 April 1968 Approved (✓) Disapproved ( )

Remarks well not Done

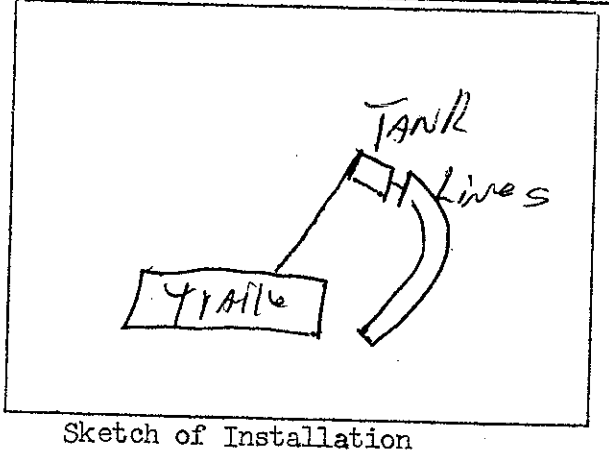

Sketch of Installation

Roy Sorgen

Sanitarian