IREDELL COUNTY HEALTH DEPARTMENT

STATESVILLE 704-878-5305 | MOORESVILLE 704-664-5281

IMPROVEMENT PERMIT / AUTHORIZATION TO CONSTRUCT / OPERATION PERMIT / EXISTING SYSTEM INSPECTION

($200) ($400)

PERMIT# 0133779 PIN# ~~4658 84 9772~~ 4658-84-7602

OWNER OR CONTRACTOR Krom Financial Services PHONE: Business 664-3671 Home

ADDRESS 144 Yacht Cove Rd. Mooresville

LOCATION 115 N. TR Barding TR new Street on Right DATE June 16, '98

SUBDIVISION Collins Park BLOCK / SECTION II LOT 14 LOT AREA .6 Ac SITE CLASS PS

Septic Tank: 1000 Gallons; STB 825 Date 8/30/98 DESIGN FLOW 360 gpd L.T.A.R. .3

Pump Tank: ___ Gallons; PT ___ Date ___

Pump Make: ___ Model ___ Serial No. ___

Nitrification Field: No Fields 1 Square Feet 1200 Linear Feet 400

No Lines 4@100' Trench Width 36" Max Trench Bottom Depth ~24"

☑ New System ☐ Repair System Type: I, II, III, IV, V, VI

System Description: gravity conventional

Repair System Description: Rpair Modified

Maintenance Agreement Required: ☐ Yes ☑ No

Gravel Depth 12"

☑ House/Mod. Home ☐ Mobile Home ☐ Business ☐ Other


No. Bedrooms 3 No. Bathrooms 2 No. Employees ___

☐ Slab ☑ Crawl Space ☐ Basement w/plumbing ☐ Basement wo/plumbing

Water Supply: ~~☑ Individual~~ ☐ Public ☐ Community

Comments:/Conditions:

INITIAL SITE SKETCH

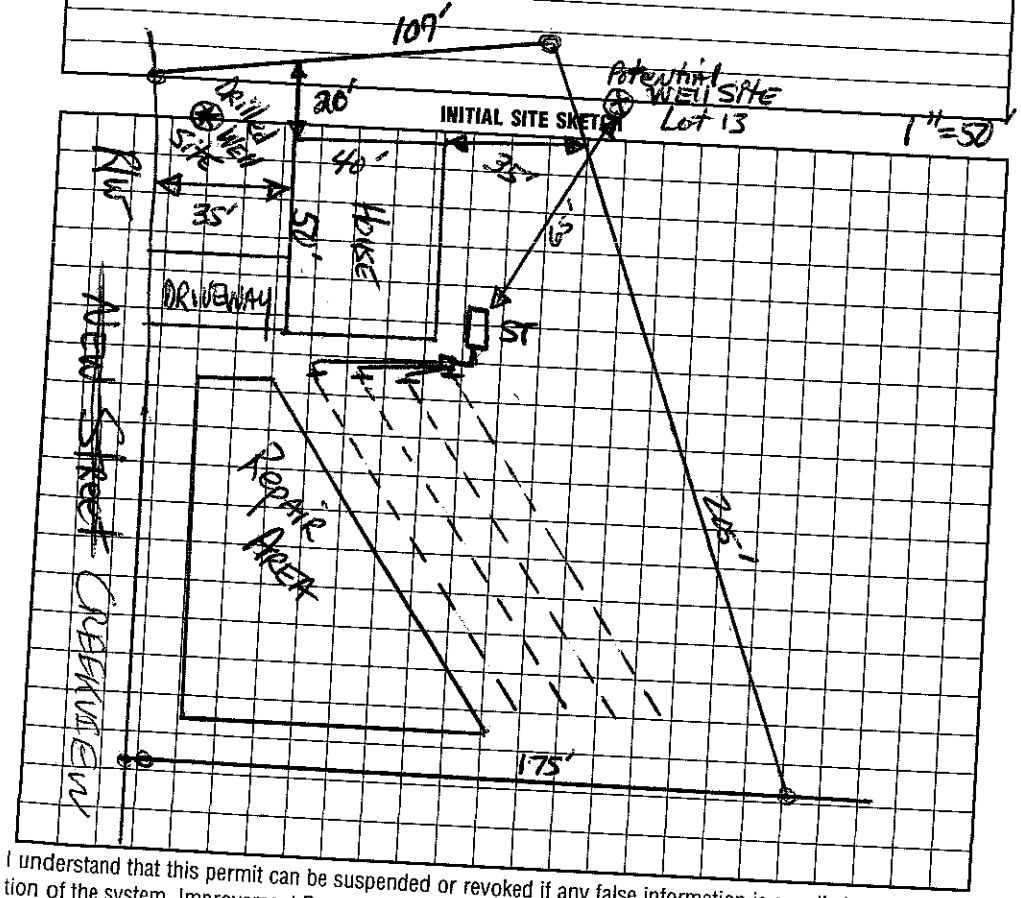

Comments:/Conditions:

AS BUILT SKETCH

I understand that this permit can be suspended or revoked if any false information is supplied toward securing the permit/any unauthorized changes are made to the site/any unauthorized changes are made in the installation of the system. Improvement Permit with plat valid without expiration. Improvement Permit with site plan valid for sixty months. Authorization to Construct is valid for a period equal to that of Improvement Permit – not to exceed sixty months.

Signed: ___

Improvement Permit by: ___ date 6-15-98

Authorization to Construct by: ___ date 6-16-98

HEALTH DEPT. COPY: WHITE INSPECTION COPY (FINAL): GREEN

Installed by: ROWAN SEPTIC

Operation Permit by: C. ___ date 10/14/98

Existing System Inspection by: ___ date 6-18-98

OWNER COPY (FINAL): YELLOW INSPECTION COPY (INITIAL): PINK OWNER COPY (INITIAL): GOLD