IREDELL COUNTY HEALTH DEPARTMENT

STATESVILLE 704-878-5305 MOORESVILLE 704-664-5281

IMPROVEMENT PERMIT / AUTHORIZATION TO CONSTRUCT / OPERATION PERMIT / EXISTING SYSTEM INSPECTION

PERMIT# 073376 PIN# 4658 84 9772 4658 84 9443 DATE June 12, '98

OWNER OR CONTRACTOR Kyom Financial Services PHONE: Business 664-3671 Home

ADDRESS 149 Yacht Cove Rd Mooresville

LOCATION 115 N. TR Barclay Ln. TR New Street on Right 128 Creek Branch Dr.

SUBDIVISION Collins Park BLOCK / SECTION II LOT 11 LOT AREA .77Ac SITE CLASS. PS DESIGN FLOW 360 gpd L.T.A.R. .03

Septic Tank: 1000 Gallons; STB 525 Date 11/7/98

Pump Tank: 1000 Gallons; PT 47 Date 11/18/98

Pump Make: Model Serial No.

Nitrification Field: No Fields 1 Square Feet 1200 Linear Feet 400

No Lines 3@133' Trench Width 36" Max Trench Bottom Depth 24" Gravel Depth 12"

☑ New System ☐ Repair System Type: I, II, III, IV, V, VI

System Description: pumped pm - conventional

Repair System Description: pumped pm shallow conv.

Maintenance Agreement Required: ☐ Yes ☑ No

☑ House/Mod. Home No. Bedrooms 3

☐ Mobile Home No. Bathrooms 2

☐ Business No. Employees

☐ Other


☐ Slab ☑ Crawl Space ☐ Basement w/plumbing ☐ Basement wo/plumbing

Water Supply: ☑ Individual ☐ Public ☐ Community

Comments:/Conditions:

Comments:/Conditions:

INITIAL SITE SKETCH

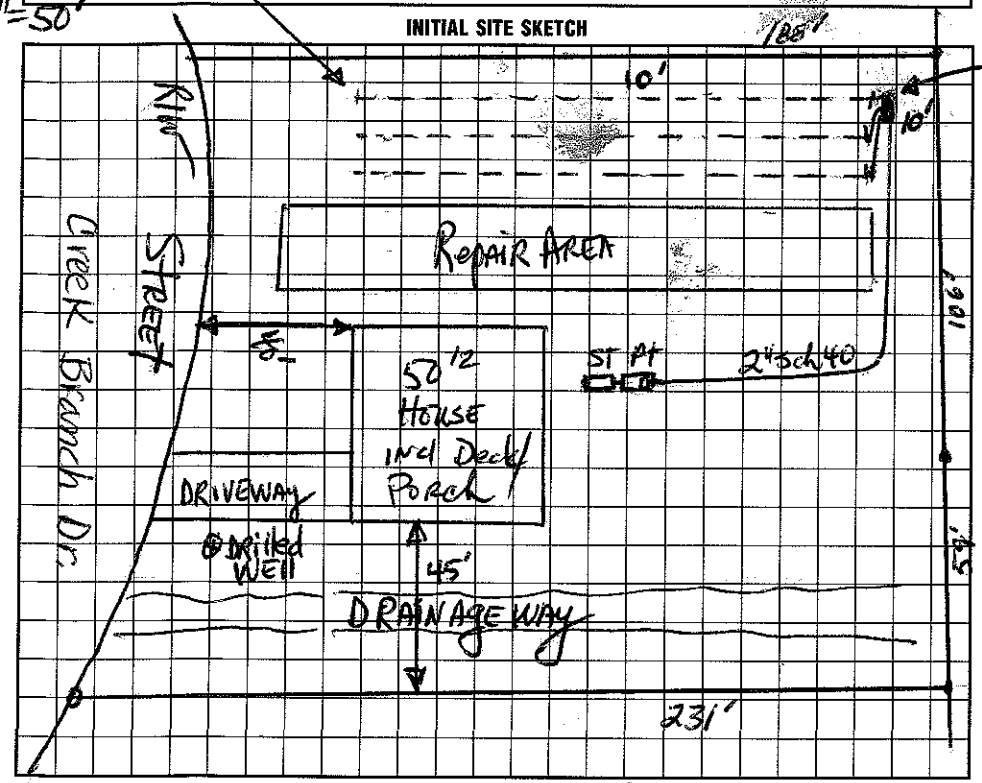

AS BUILT SKETCH

I understand that this permit can be suspended or revoked if any false information is supplied toward securing the permit/any unauthorized changes are made to the site/any unauthorized changes are made in the installation of the system. Improvement Permit with plat valid without expiration. Improvement Permit with site plan valid for sixty months. Authorization to Construct is valid for a period equal to that of Improvement Permit – not to exceed sixty months.

Signed: X date 6-19-98 Installed by: Rowan Septic

Improvement Permit by: David R. Thomas, RS date 6-12-98 Operation Permit by: David R. Thomas R.S. date 1/13/99

Authorization to Construct by: David R. Thomas, RS date 6-18-98 Existing System Inspection by: date

HEALTH DEPT. COPY: WHITE INSPECTION COPY (FINAL): GREEN OWNER COPY (FINAL): YELLOW INSPECTION COPY (INITIAL): PINK OWNER COPY (INITIAL): GOLD