10:50

IREDELL COUNTY HEALTH DEPARTMENT

STATESVILLE 704-878-5305 MOORESVILLE 704-664-5281

IMPROVEMENT PERMIT / AUTHORIZATION TO CONSTRUCT / OPERATION PERMIT / EXISTING SYSTEM INSPECTION

PERMIT# 073366 PIN# 4658849772 4658849665 DATE May 26, '98

OWNER OR CONTRACTOR from Financial Services PHONE: Business 664-3671 Home

ADDRESS 149 Yacht Cove Rd., Mooresville

LOCATION 115 N. TR Barclay Lane TR New Street on left 119 Creek Branch Dr.

SUBDIVISION Collins Park BLOCK / SECTION II LOT 2 LOT AREA .87Ac SITE CLASS. PS DESIGN FLOW 360gpd L.T.A.R. .3

Septic Tank: 1000 Gallons; STB 794 Date 5/2/00
Pump Tank: 1000 Gallons; PT 27 Date 2/7/00
Pump Make: Goulds Model WE05511H Serial No. D0034474
Nitrification Field: No Fields 1 Square Feet 900 Linear Feet 300
No Lines 3 @ 100' Trench Width 36" Max Trench Bottom Depth (18") Gravel Depth NA

☑ New System ☐ Repair System Type: I, II, III, IV, V, VI
System Description: Pumped-on-Modified 25% Red.
Repair System Description: Same
Maintenance Agreement Required: ☐ Yes ☑ No

☑ House/Mod. Home No. Bedrooms 3
☐ Mobile Home No. Bathrooms 2
☐ Business No. Employees
☐ Other
☐ Slab ☑ Crawl Space ☐ Basement w/plumbing ☐ Basement wo/plumbing


Water Supply: ☑ Individual ☐ Public ☐ Community

Comments:/Conditions: * ONE INSpection/observation port per LATERAL. Septic System Installer note maximum trench bottom depth.

Comments:/Conditions: Filter installed. Tanks, lines & pressure Checked 6/16/2000.

1" = 50'

INITIAL SITE SKETCH

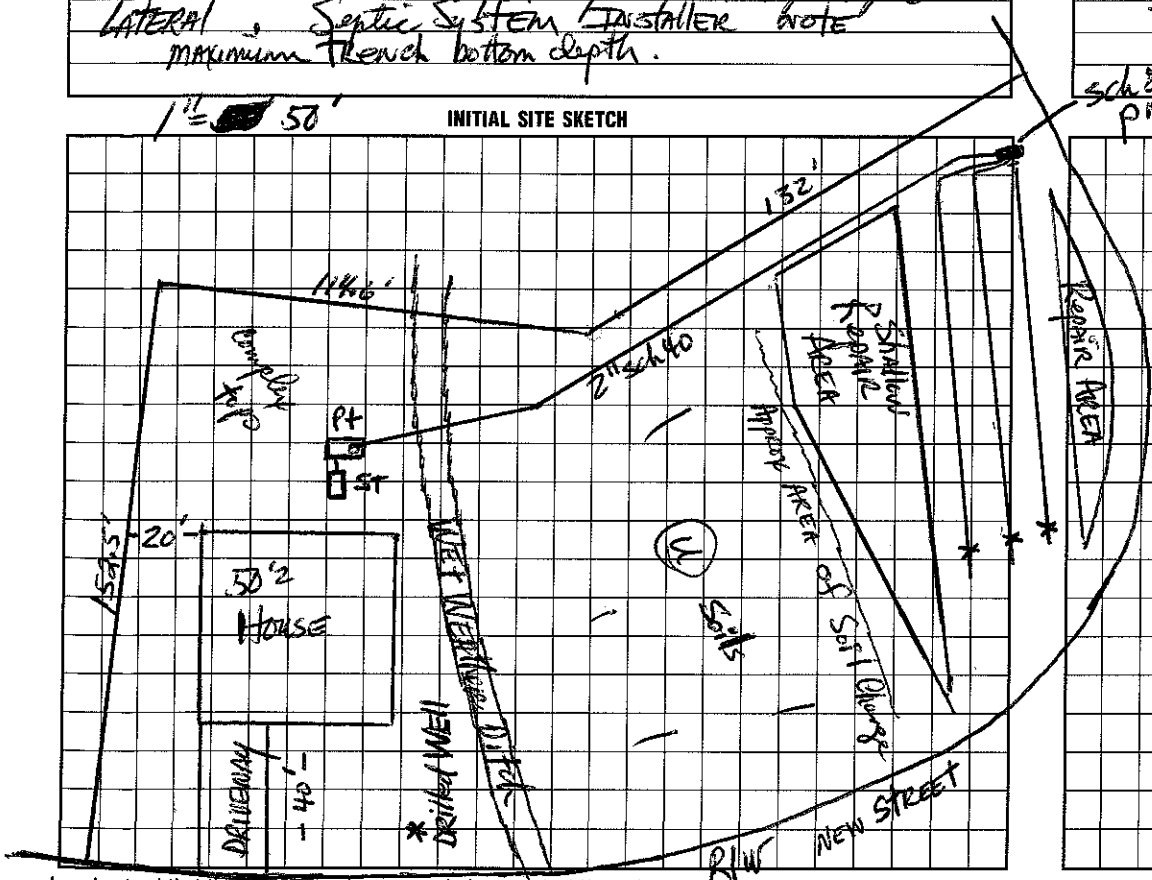

AS BUILT SKETCH

I understand that this permit can be suspended or revoked if any false information is supplied toward securing the permit/any unauthorized changes are made to the site/any unauthorized changes are made in the installation of the system. Improvement Permit with plat valid without expiration. Improvement Permit with site plan valid for sixty months. Authorization to Construct is valid for a period equal to that of Improvement Permit – not to exceed sixty months.

Signed: * date 6-18-98 Installed by: F.J. Ervin

Improvement Permit by: [signature], RS date 5-26-98 Operation Permit by: [signature] RS date 6/21/00

Authorization to Construct by: [signature] RS date 6-18-98 Existing System Inspection by: date

HEALTH DEPT. COPY: WHITE INSPECTION COPY (FINAL): GREEN OWNER COPY (FINAL): YELLOW INSPECTION COPY (INITIAL): PINK OWNER COPY (INITIAL): GOLD