IREDELL COUNTY HEALTH DEPARTMENT

STATESVILLE 704-878-5305 MOORESVILLE 704-664-5281

IMPROVEMENT PERMIT / AUTHORIZATION TO CONSTRUCT / OPERATION PERMIT / EXISTING SYSTEM INSPECTION

PERMIT # 156336 PIN # 4658-85-5655 DATE 5-6-09

OWNER or APPLICANT RONALD + MONIKA FANDREY PHONE: Business 980-343-5815 Home:

OWNER or APPLICANT ADDRESS 3922 LAKE RD CHARLOTTE NC 28269

LOCATION / DIRECTIONS 115 N, TR BARCLAY, END ON L

SUBDIVISION — BLOCK / SECTION — LOT # — LOT AREA 5.15AC DESIGN FLOW 360 L.T.A.R. .25

Septic Tank 1000 Gallons: STB 312 Date 9-15-12
Pump Tank Gallons: P T Date
Pump Make Model Serial #
Nitrification Field No Fields 1 No Lines 4 Linear Feet 360'
Trench Width 36" Max. Trench Bottom Depth 36" Gravel Depth —

☒ New System ☐ Repair ☐ Expansion System Type I II III IV V VI
System Description: GRAVITY 25% REDUCTION
Repair System Description: SAME
Maintenance Agreement Required ☐ YES ☒ NO
☒ GRAVITY ☐ PRESSURE


☒ Residence No. Bedrooms 3
☐ Business No. Persons
☐ Other No. Employees
☐ Slab ☒ Crawl Space
☒ Basement w/plumbing ☐ Basement w/o plumbing

Water Supply: ☒ Private ☐ Public ☐ Community


Comments / Conditions 1) MAINTAIN ALL REQUIRED SETBACKS

Comments / Conditions 5/22/2012 Reviewed Floor Plans in compliance with I.P. (See revised site plan 5/22/12)

INITIAL SITE SKETCH

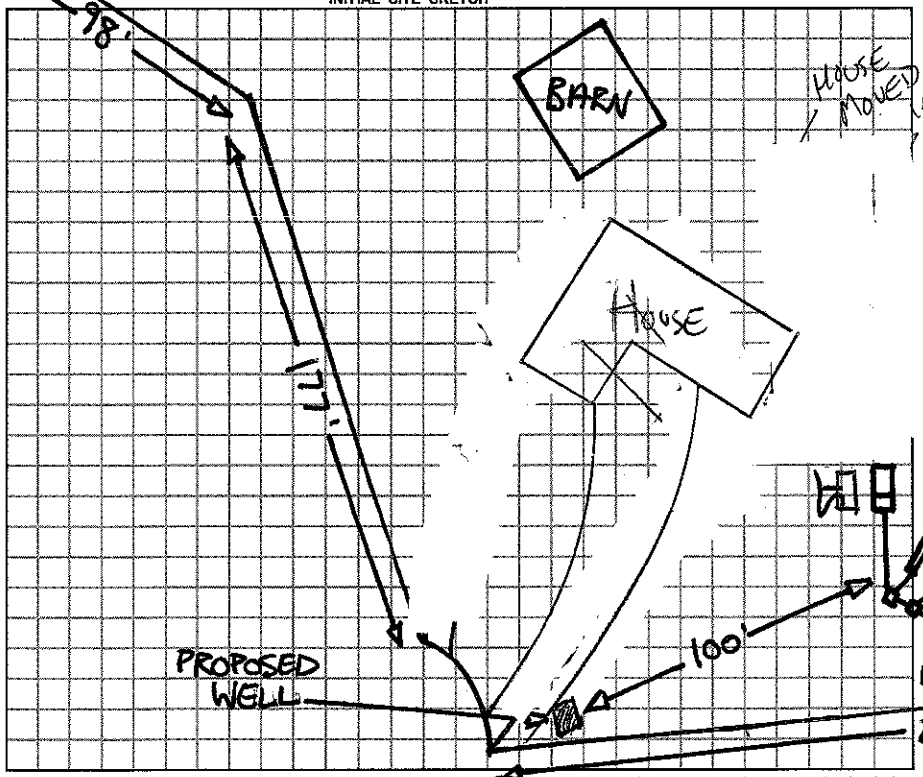

AS BUILT SKETCH

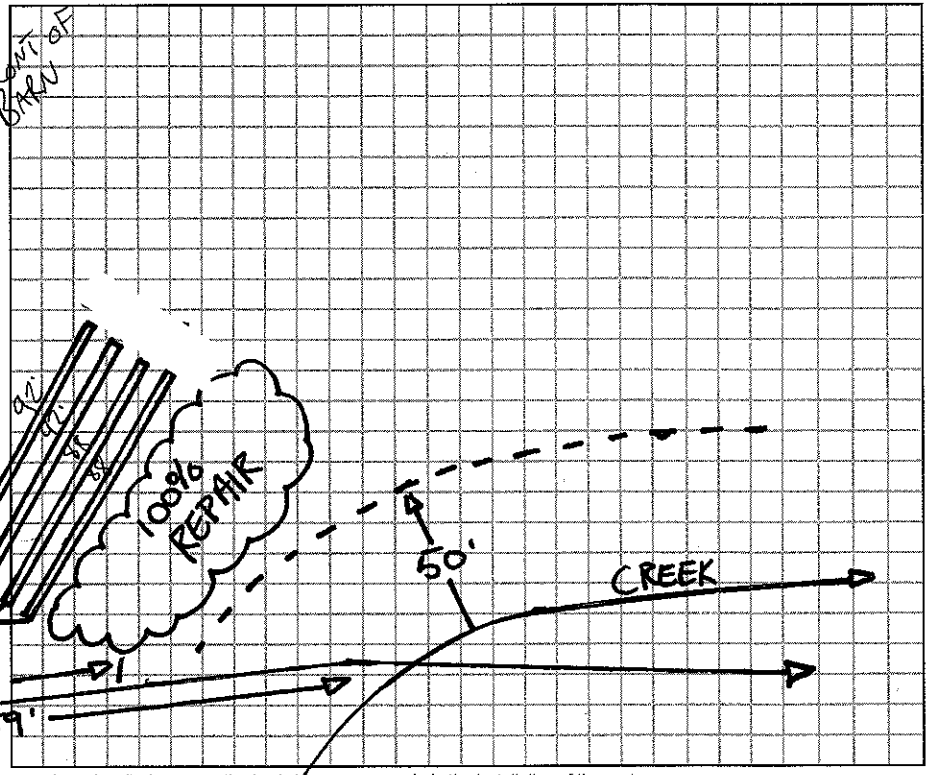

Permit can be suspended or revoked if any false information is supplied toward securing the permit / any unauthorized changes are made to the site / any unauthorized changes are made in the installation of the system.

☐ *IMPROVEMENT PERMIT w / site plan not valid without expiration* ☒ *IMPROVEMENT PERMIT w / site plan valid for 60 mos.* ☐ *AUTHORIZATION TO CONSTRUCT valid for period equal to IMPROVEMENT PERMIT-not to exceed 60 mo.*

Owner / Applicant Signature: Monika Fandrey Date 7/10/09

Improvement Permit by: Date 5-6-09

Authorzation to Construct by: Date 5-22-12

Installed by: BEAM

Operation Permit by: Date: 10-30-12

Existing System Inspected by: Date:

YOU SHOULD CONTACT A LOCATOR SERVICE PRIOR TO ANY EXCAVATION.

WHITE COPY Environmental Health YELLOW COPY (Final) Owner / Applicant PINK COPY (Initial) Owner / Applicant