IREDELL COUNTY HEALTH DEPARTMENT

Statesville Phone TR 3-7271 — Mooresville Phone No. 664-5281

PERMIT TO INSTALL SEPTIC TANK

Permit No. 4 — Permit Date 1-15- 1973

Owner Quarry o'donnel — Address Mooresville

Installed By Orbison — Address Mooresville


Location of Property 115 N to Collins Park House 5 on right on main road in

Tank		Capacity		Length of Lines		Fixtures	
Block	( )	1000	(✓)	225'	( )	No. of Baths	(2)
Precast	(✓)	1250	( )	250'	( )	Dishwasher	(no)
		1500	( )	Other 240'		Garbage Grdr.	(no)
		Other				Other Washing machine	

NOTIFY HEALTH DEPARTMENT AT LEAST EIGHT HOURS BEFORE TANK IS TO BE INSPECTED.

Final Inspection 1-15- 1973 — Approved (✓) Disapprcved ( )

Remarks

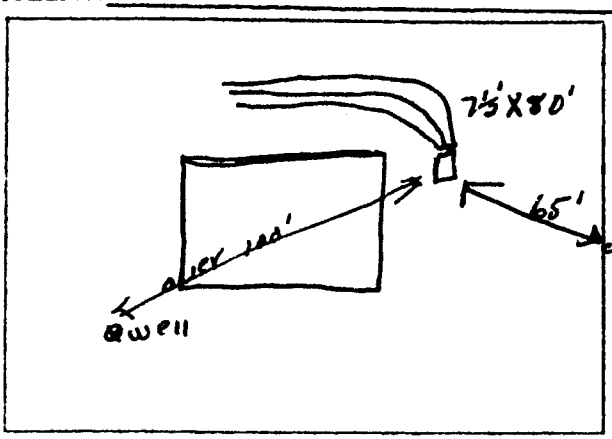

Sketch of Installation

J. C. Moore
Sanitarian