663 - 3393

IREDELL COUNTY HEALTH DEPARTMENT

STATESVILLE 704-878-5305 MOORESVILLE 704-664-5281

IMPROVEMENT PERMIT / CERTIFICATE OF COMPLETION / OPERATION PERMIT / EXISTING SYSTEM INSPECTION

PROPERTY DESCRIPTION NO. 23204 DATE 3/12/96 TAX MAP NO. 10-4-53A 4658-88-1020 Watershed: ☐ Yes ☑ No

OWNER OR CONTRACTOR Pauline Woodman PHONE: Business _____ Home 662-6056

ADDRESS 133 Continental Dr. Mooresville 28115

LOCATION 21/115S TL shinville Rd - 1st lot on left

SUBDIVISION _____ BLOCK / SECTION _____ LOT _____ LOT AREA (+-) 3ac SITE CLASS. RS DESIGN FLOW 480 L.T.A.R. .25 gpd/ft2

Septic Tank: 1000 Gallons; STB 794 Date 1-29-96

Pump Tank: 1000 Gallons; PT 27 Date 3-22-96

Pump Make: Zoeller Model N98-062 Serial No. _____

Nitrification Field: No Fields 1 Square Feet ~~1890~~ 1540 Linear Feet ~~630~~ 630

No Lines 7 Trench Width 36" Max Trench Bottom Depth 36" Gravel Depth 12"

☑ New System ☐ Repair System Type: I, II, III, IV, V, VI

System Description: Pump Conventional

Repair System Description: same

Maintenance Agreement Required: ☐ Yes ☑ No

☐ House/Mod. Home ☑ Mobile Home ☐ Business ☐ Other

No. Bedrooms 4 No. Bathrooms 2 No. Employees _____


☐ Slab ☐ Crawl Space ☐ Basement w/plumbing ☐ Basement wo/plumbing

Water Supply: ☑ Individual ☐ Community ☐ Public


Comments:

Comments: ~~Comments~~ Lines, Pressure, Tanks, Distribution checked on 4/29/96. Electrical needs to be checked. (NEMA 4X Box, Alarm, Circuits)

INITIAL SITE SKETCH

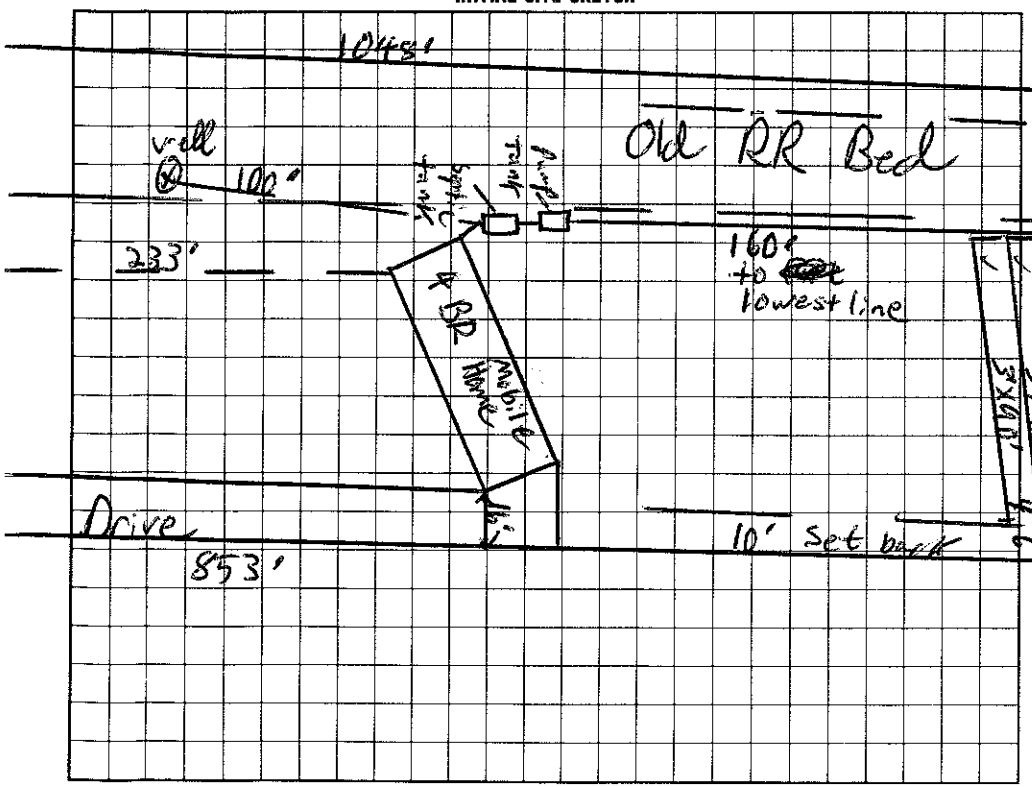

AS BUILT SKETCH

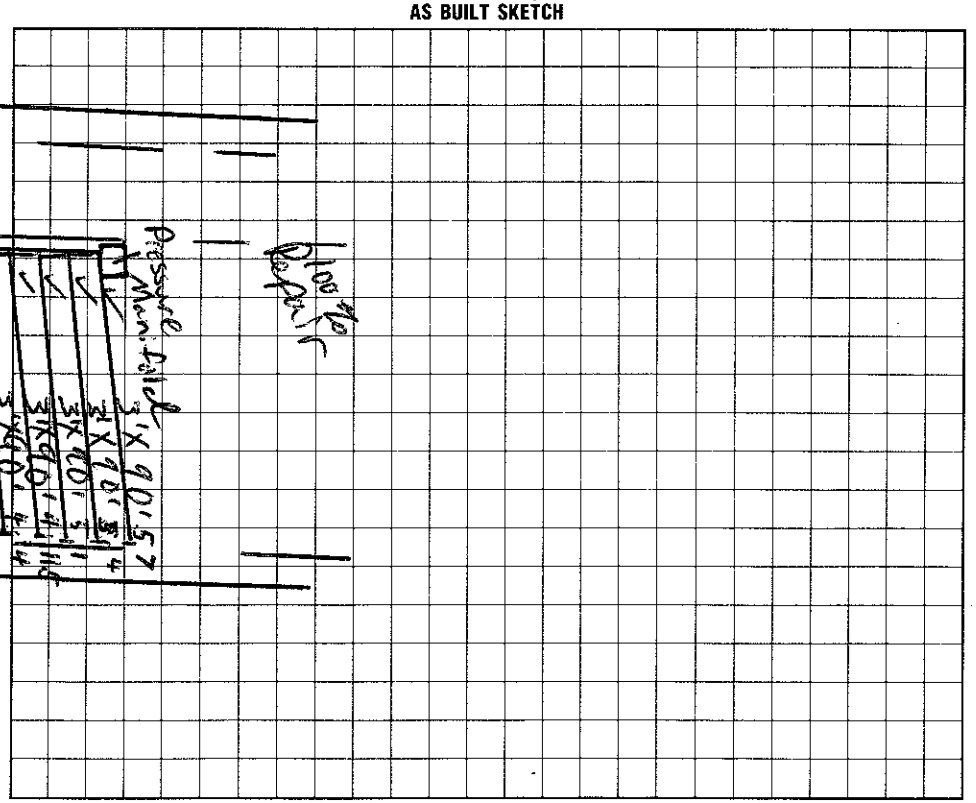

I understand that this permit can be suspended or revoked if any false information is supplied toward securing the permit/any unauthorized changes are made to the site/any unauthorized changes are made in the installation of the system.

Signed: X Janet Morton

Improvement Permit by: C. Bob Freeman EHSI date 3/11/96

Existing System Inspection by: C. Bob Freeman EHSI date 3/11/96

Installed by: Julian Bowles

Certificate of Completion by: _____ date _____

Operation Permit by: Wesley Sparks R.S. date 8/28/96

HEALTH DEPT. COPY: WHITE INSPECTION COPY (FINAL): GREEN OWNER COPY (FINAL): YELLOW INSPECTION COPY (INITIAL): PINK OWNER COPY (INITIAL): GOLD

Authorization to Construct is valid for 60 months from date of issue.