IREDELL COUNTY HEALTH DEPARTMENT

Statesville Office (704) 878-5305 Mooresville Office (704) 660-3625 PERMIT # 201600

IMPROVEMENT PERMIT / AUTHORIZATION TO CONSTRUCT / OPERATION PERMIT / EXISTING SYSTEM

PIN # 4658892245

APPLICANT: Champion Window Co. APPLICANT ADDRESS: 9100 Perimeter Wood Dr.

SITE ADDRESS: 1575 Charlotte Hwy PHONE: 980-722-6641 ALT. PHONE: N/A

SITE DIRECTIONS: Hwy 115/21 S Property on Left.

SUBDIVISION: N/A SECTION: N/A LOT # N/A LOT AREA: 2.18 acres DESIGN FLOW: 360gpd L.T.A.R.: Existing

Septic Tank 1000 (gal) STB 760 Date 9-30-13
Pump Tank (gal) PT Date
Pump Make Model Serial #
Nitrification Fields 6x # Lines 6x Linear Ft: 6x
Trench Width 6x Max. Trench Bottom Depth 6x Gravel Depth 6x

☐ New System ☐ Repair ☐ Expansion System Type: I ☑ II III IV V VI
System Description: TANK
Repair System Description:
Maintenance Agreement Required: ☐ YES ☑ NO
☑ GRAVITY ☐ PRESSURE


☑ Residence No. Bedrooms 3
☐ Business No. Persons 6
☐ Other No. Employees
☐ Slab ☑ Crawl Space
☐ Basement w/plumbing ☐ Basement w/o plumbing

Water Supply: ☑ Private ☐ Public ☐ Community

Comments / Conditions: Set new septic tank at location shown below & connect to existing drainfield. Disconnect existing septic tank & pump it dry.

* New O-Box installed, speed levelers installed
* Existing ST could not be pumped due to it's location under home

INITIAL SITE SKETCH

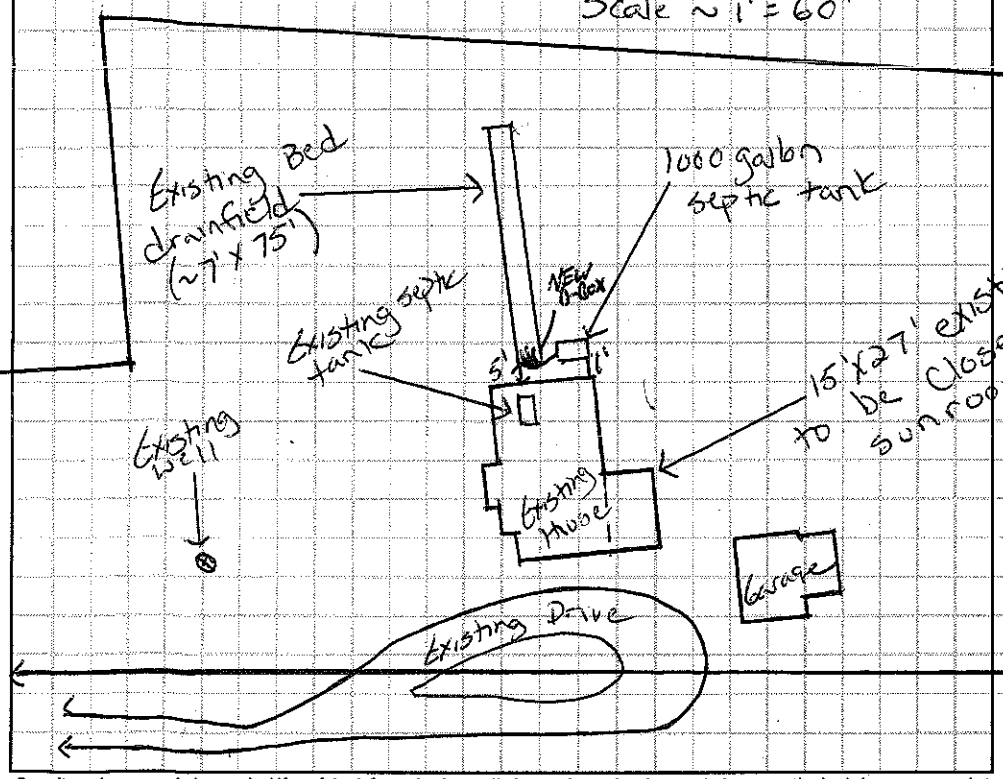

AS BUILT SKETCH

Permit can be suspended or revoked if any false information is supplied toward securing the permit / any unauthorized changes are made to the site / any unauthorized changes are made in the installation of the system. **CONTACT A LOCATOR SERVICE PRIOR TO ANY EXCAVATION**

☐ **IMPROVEMENT PERMIT** *with plat valid without expiration.* ☑ **IMPROVEMENT PERMIT** *with site plan valid for 60 mos.* ☑ **AUTHORIZATION TO CONSTRUCT** *valid for period equal to IMPROVEMENT PERMIT--not to exceed 60 mo.*

Owner / Applicant Signature: Edward L. Mills Date: 3-20-14 Installed by: Lentz

IMPROVEMENT PERMIT by: Justin Henderson Date: 3-20-14 OPERATION PERMIT by: [signature] Date: 3-31-14

AUTHORIZATION TO CONSTRUCT by: Justin Henderson Date: 3-20-14 Existing System Inspected by: Date:

Health Dept. Copy - WHITE Applicant (Final Approval) - YELLOW Applicant (Conditional Approval) - PINK