IREDELL COUNTY HEALTH DEPARTMENT

STATESVILLE 704-878-5305 — MOORESVILLE 704-664-528?

paid 175.00 — LARRY TUCKER @ (330). 11:00

IMPROVEMENT PERMIT / AUTHORIZATION TO CONSTRUCT / OPERATION PERMIT / EXISTING SYSTEM INSPECTION

PERMIT# 090859 PIN# 4658995249 (pt) 4658-87-4296 ✓ N DATE October 16 2000

OWNER OR CONTRACTOR Mid Carolina Dev. // Fleetwood Homes PHONE: Business 634-0173 Home

ADDRESS P.O. Box 1580 Cornelius

LOCATION 115 N. TR Shinnville Rd. TL Carolina Acres Drive TL Barnswallow Lane TR Skylark Lane

SUBDIVISION Grace Meadows BLOCK / SECTION LOT 18 LOT AREA 44829 sf SITE CLASS RS for 1452 DESIGN FLOW 360 gpd L.T.A.R. .25

Septic Tank: 1000 Gallons; STB 312 Date 10-15-00

Pump Tank: 1000 Gallons; PT 27 Date 11-19-00

Pump Make: Model Serial No.

Nitrification Field: No Fields 1 Square Feet 750 Linear Feet 250

No Lines 5 @ 50 45 Trench Width 36" Max Trench Bottom Depth 36"

☑ New System ☐ Repair System Type: I, II, (III), IV, V, VI

System Description: PM Panel Block

Repair System Description: LP Panel Block

Maintenance Agreement Required: ☐ Yes ☑ No Gravel Depth NA

☑ House/Mod. Home No. Bedrooms 3

☐ Mobile Home No. Bathrooms 2

☐ Business No. Employees

☐ Other


☐ Slab ☑ Crawl Space ☐ Basement w/plumbing ☐ Basement wo/plumbing

Water Supply: ☑ Individual ☐ Public ☐ Community


Comments:/Conditions: Stormwater Berm must be installed above system area prior to issuance of O.P.
10-31-00 Removed floor plan - appears OK

Comments:/Conditions: Polylok filter installed & riser MH not set up yet, well not [illegible] Checked tanks 11/4/2000 & ok [illegible] 5/15/2001 Press. Electd alarm Checked in 12/2001 Checked 6/19/2001

INITIAL SITE SKETCH 1" = 50'

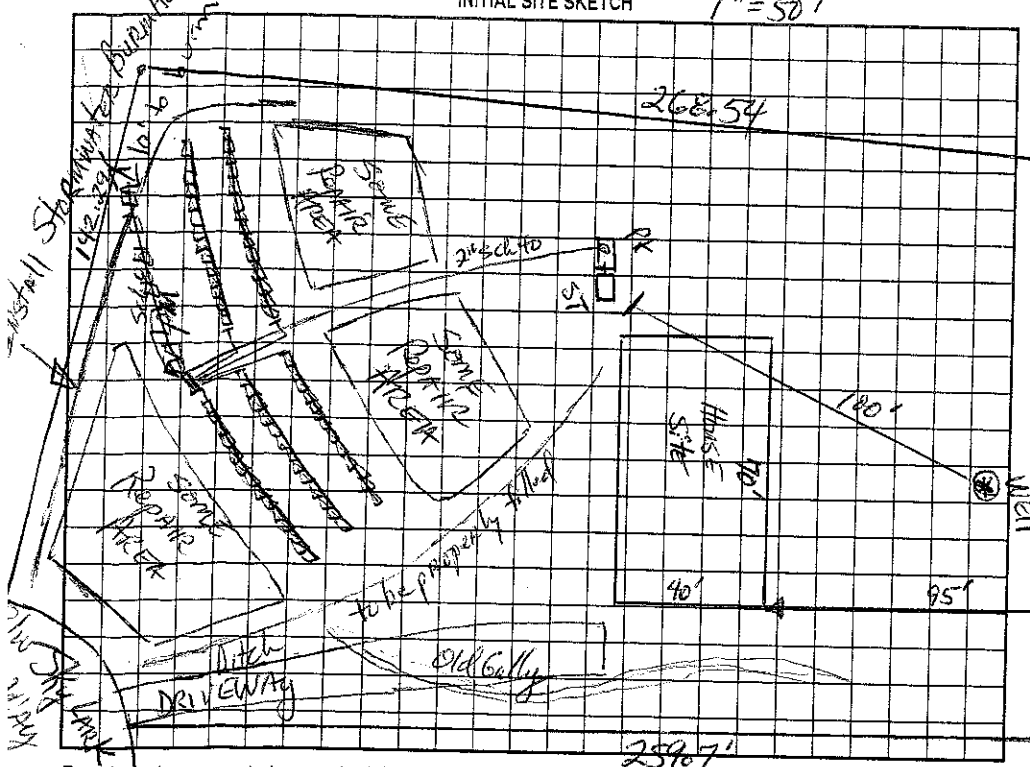

AS BUILT SKETCH

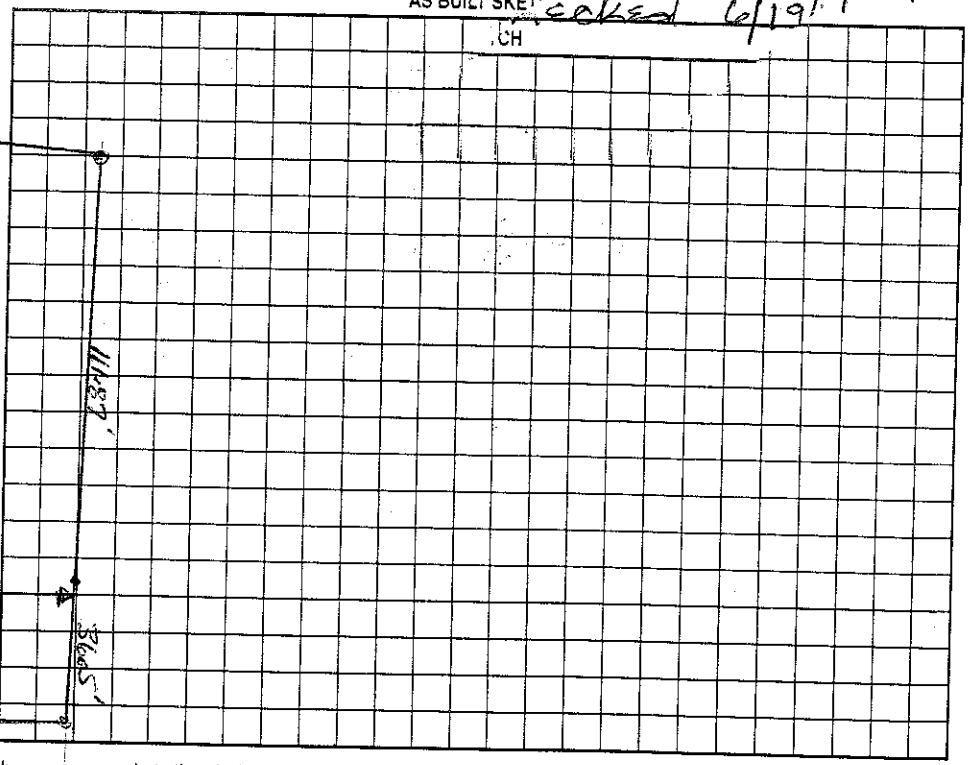

Permit can be suspended or revoked if any false information is supplied toward securing the permit/any unauthorized changes are made to the site/any unauthorized changes are made in the installation of the system. Improvement Permit with plat valid without expiration. Improvement Permit with site plan valid for sixty months. Authorization to Construct is valid for a period equal to that of Improvement Permit – not to exceed sixty months.

Signed: date 10/16/00

Improvement Permit by: RS date 10-16-00

Authorization to Construct by: RS date 10-31-00

Installed by: finished Carolina Pipe Cleaning

Operation Permit by: RS date 6/19/2001

Existing System Inspection by: date

HEALTH DEPT. COPY: WHITE OWNER COPY (FINAL): YELLOW OWNER COPY (INITIAL): PINK