350.00 Paid

IREDELL COUNTY HEALTH DEPARTMENT

STATESVILLE 704-878-5305 MOORESVILLE 704-664-5281

IMPROVEMENT PERMIT / AUTHORIZATION TO CONSTRUCT / OPERATION PERMIT / EXISTING SYSTEM INSPECTION

PERMIT# Repair PIN# 4658925473 DATE 4/3/05

OWNER OR APPLICANT Timothy Brawley PHONE: Business Home 704-864-2745

ADDRESS 4417 Farmbrook Rd Gastonia NC 28056

LOCATION HWY 115 N, on Lt before Mazeppa #2240

SUBDIVISION BLOCK / SECTION LOT LOT AREA SITE CLASS. PS DESIGN FLOW 360 L.T.A.R. —

Septic Tank: Existing Gallons; STB Date

Pump Tank: Gallons; PT Date

Pump Make: Model Serial No.

Nitrification Field: No Fields Square Feet 480 Linear Feet 160+

No Lines 2 Trench Width 36" Trench Bottom Depth 36" Gravel Depth 12" ☒ Gravity ☐ Pressure

☐ New System ☒ Repair ☐ Expansion System Type: ☐ I ☐ II ☐ III ☐ IV ☐ V ☐ VI

System Description:

Repair System Description: Conventional

Maintenance Agreement Required: ☐ Yes ☒ No

☒ House/Mod. Home No. Bedrooms 3

☐ Mobile Home No. Persons

☐ Business No. Employees

☐ Other


Water Supply: ☒ Individual ☐ Public ☐ Community

☐ Slab ☐ Crawl Space ☐ Basement w/plumbing ☐ Basement wo/plumbing


Comments:/Conditions: Can use Accepted 25% Reduction Material but do not reduce Length. Must plumb Washer drain to Septic Tank.

Comments:/Conditions:

INITIAL SITE SKETCH

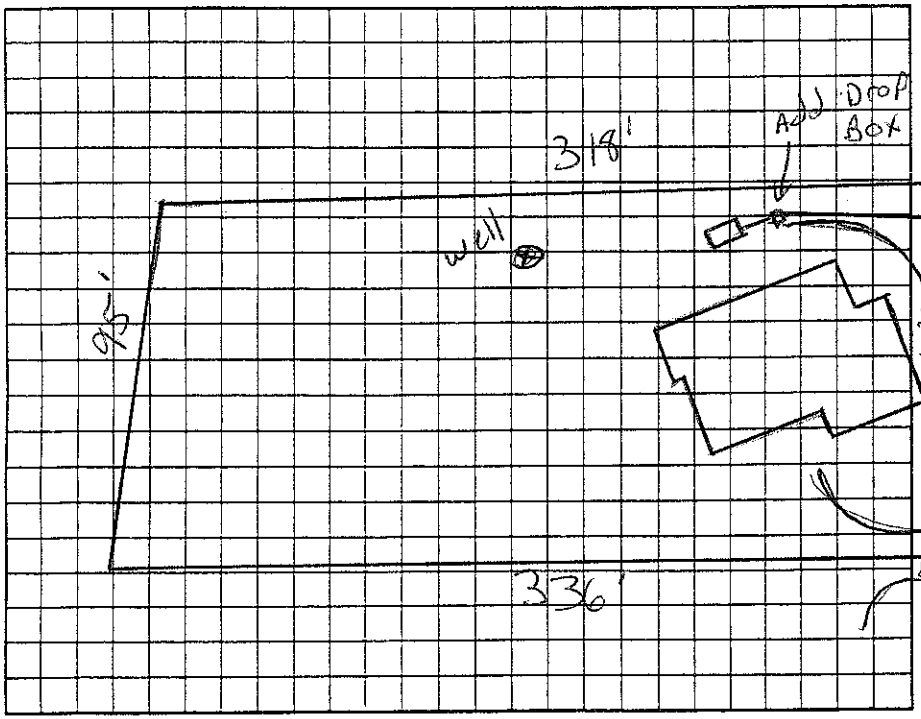

AS BUILT SKETCH

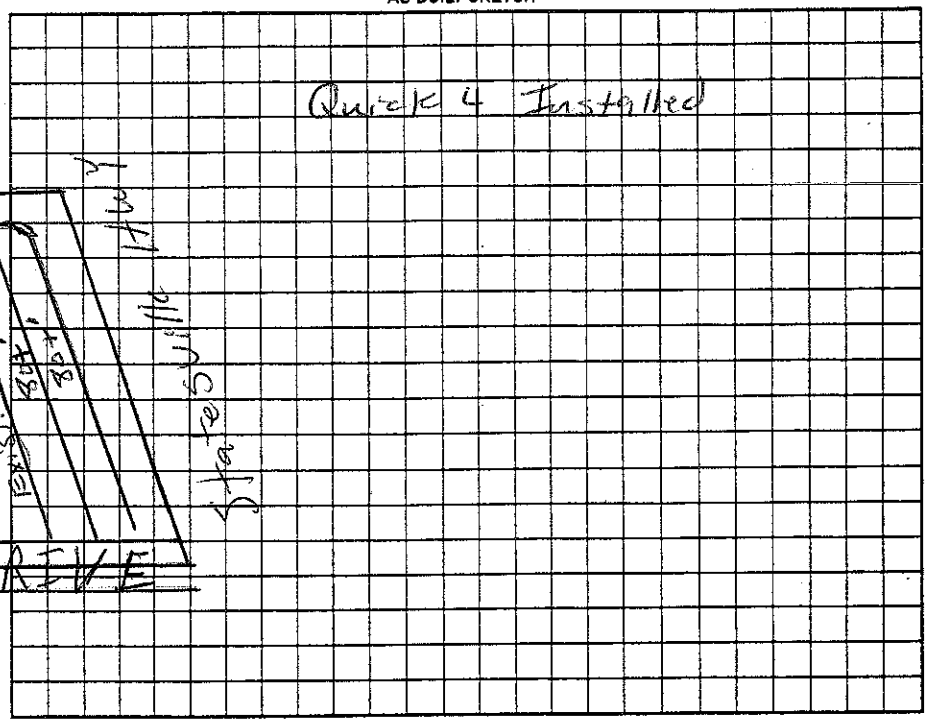

Permit can be suspended or revoked if any false information is supplied toward securing the permit/any unauthorized changes are made to the site/any unauthorized changes are made in the installation of the system. Improvement Permit with plat valid without expiration ☐ Improvement Permit with site plan valid for sixty months ☐ Authorization to Construct is valid for a period equal to that of Improvement Permit – not to exceed sixty months.

Signed: Timothy E. Brawley date 4-3-06

Improvement Permit by: RS date 4/3/06

Authorization to Construct by: RS date 4/3/06

Installed by: Abernathy

Operation Permit by: RS date 5/3/06

Existing System Inspection by: date

HEALTH DEPT. COPY: WHITE OWNER COPY (FINAL): YELLOW OWNER COPY (INITIAL): PINK