4658930435

# IREDELL COUNTY HEALTH DEPARTMENT

STATESVILLE 704-878-5305 MOORESVILLE 704-664-5281

## IMPROVEMENT PERMIT / CERTIFICATE OF COMPLETION / OPERATION PERMIT / EXISTING SYSTEM INSPECTION

PROPERTY DESCRIPTION NO. _____ DATE 4/13/95 TAX MAP NO. _____ Watershed: ☐ Yes ☐ No

OWNER OR CONTRACTOR Robbie Ludwig PHONE: Business 664-2121 Home 664-9439

ADDRESS 2186 Statesville Hwy Mooresville NC 28115

LOCATION 115 N, past Mazeppa Rd, 3rd Hse on LF

SUBDIVISION _____ BLOCK / SECTION 1 LOT _____ LOT AREA _____ SITE CLASS. _____ DESIGN FLOW _____ L.T.A.R. _____

Septic Tank: Exist Gallons; STB _____ Date _____

Pump Tank: _____ Gallons; PT _____ Date _____

Pump Make: _____ Model _____ Serial No. _____

Nitrification Field: No Fields 1 Square Feet 720 Linear Feet 120'

No Lines 2 w 6' Bed Trench Width 6' Max Trench Bottom Depth 30" Gravel Depth 18"

☐ New System ☑ Repair System Type: I, II, III, IV, V, VI

System Description: conventional gravity

Repair System Description: _____

Maintenance Agreement Required: ☐ Yes ☐ No

☑ House/Mod. Home No. Bedrooms 3

☐ Mobile Home No. Bathrooms 1

☐ Business No. Employees _____

☐ Other _____


☐ Slab ☑ Crawl Space ☐ Basement w/plumbing ☐ Basement wo/plumbing

Water Supply:
☑ Individual
☐ Community
☐ Public
on site

Comments: New 6'x120' Bed w/ 21 lines. 18" stone - 12" under and 2" over pipe. Set "D" Box w/ speed levelers to feed new lines & ext. Pump Tank.

Comments: Installed as shown.

### INITIAL SITE SKETCH

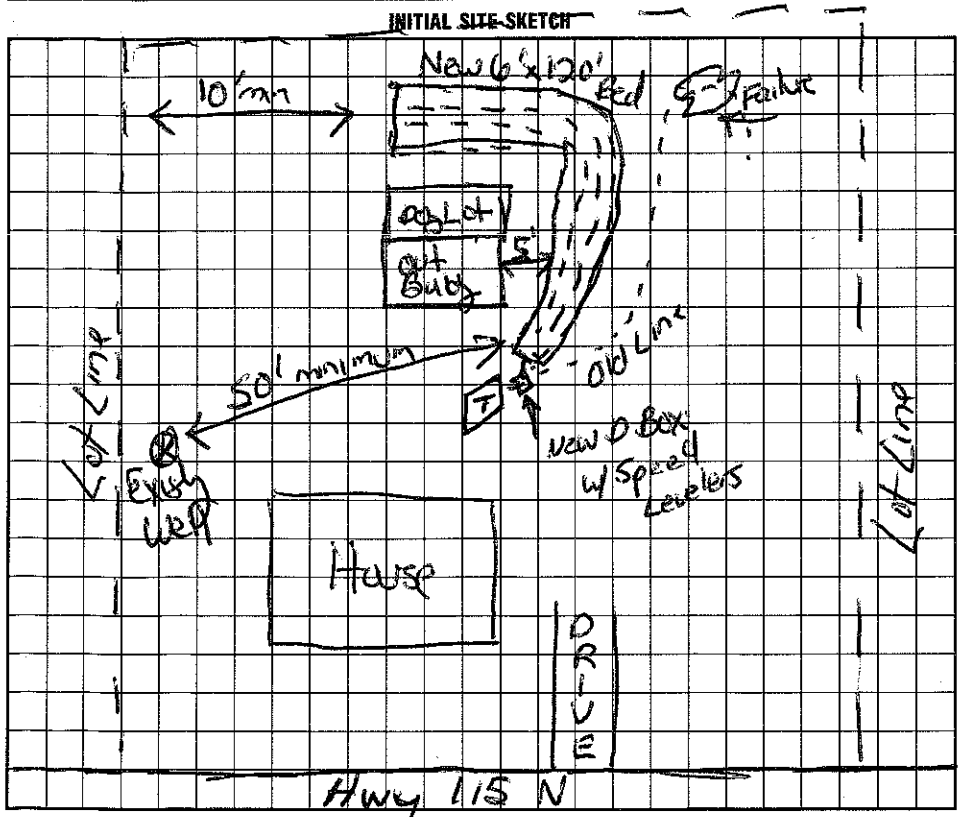


### AS BUILT SKETCH

I understand that this permit can be suspended or revoked if any false information is supplied toward securing the permit/any unauthorized changes are made to the site/any unauthorized changes are made in the installation of the system. Improvement Permit is valid for 60 months from date of issuance.

Signed: _____

Improvement Permit by: _____ date 4/13/95

Existing System Inspection by: _____ date _____

Installed by: Robbie Ludwig

Certificate of Completion by: Wesley Sparks date _____

Operation Permit by: _____ date _____

HEALTH DEPT. COPY: WHITE INSPECTION COPY (FINAL): GREEN OWNER COPY (FINAL): YELLOW INSPECTION COPY (INITIAL): PINK OWNER COPY (INITIAL): GOLD