3:30

IREDELL COUNTY HEALTH DEPARTMENT

STATESVILLE 704-878-5305 MOORESVILLE 704-664-5281

IMPROVEMENT PERMIT / AUTHORIZATION TO CONSTRUCT / OPERATION PERMIT / EXISTING SYSTEM INSPECTION

PERMIT# 073375 PIN# 4658849772 4658-94-1411 DATE June 10, '98

OWNER OR CONTRACTOR Kuan Financial Services PHONE: Business 664-3671 Home

ADDRESS 149 Yacht Cove Rd. Mooresville

LOCATION 115 N. TR Barclay Ln. TR New Street on Right

SUBDIVISION Collins Park BLOCK / SECTION II LOT 110 LOT AREA .0732 SITE CLASS. 1S DESIGN FLOW 360gpd L.T.A.R. .3

Septic Tank: 1000 Gallons; STB 825 Date 11/11/98
Pump Tank: Gallons; PT Date
Pump Make: Model Serial No.
Nitrification Field: No Fields 2 Square Feet 1200 Linear Feet 400
No Lines 3+3 Trench Width 36" Max Trench Bottom Depth 18-20" Gravel Depth 12"

☑ New System ☐ Repair System Type: I, II, III, IV, V, VI
System Description: gravity conventional
Repair System Description: gravity/pumped Repair Area
Maintenance Agreement Required: ☐ Yes ☐ No

☑ House/Mod. Home No. Bedrooms 3
☐ Mobile Home No. Bathrooms 2
☐ Business No. Employees
☐ Other
☐ Slab ☑ Crawl Space ☐ Basement w/plumbing ☐ Basement wo/plumbing


Water Supply: ☑ Individual ☐ Public ☐ Community

Comments:/Conditions: Distribution System Consists of flow divider to 2 D-Boxes w/speed levelers

Comments:/Conditions:

INITIAL SITE SKETCH

1" = 50'

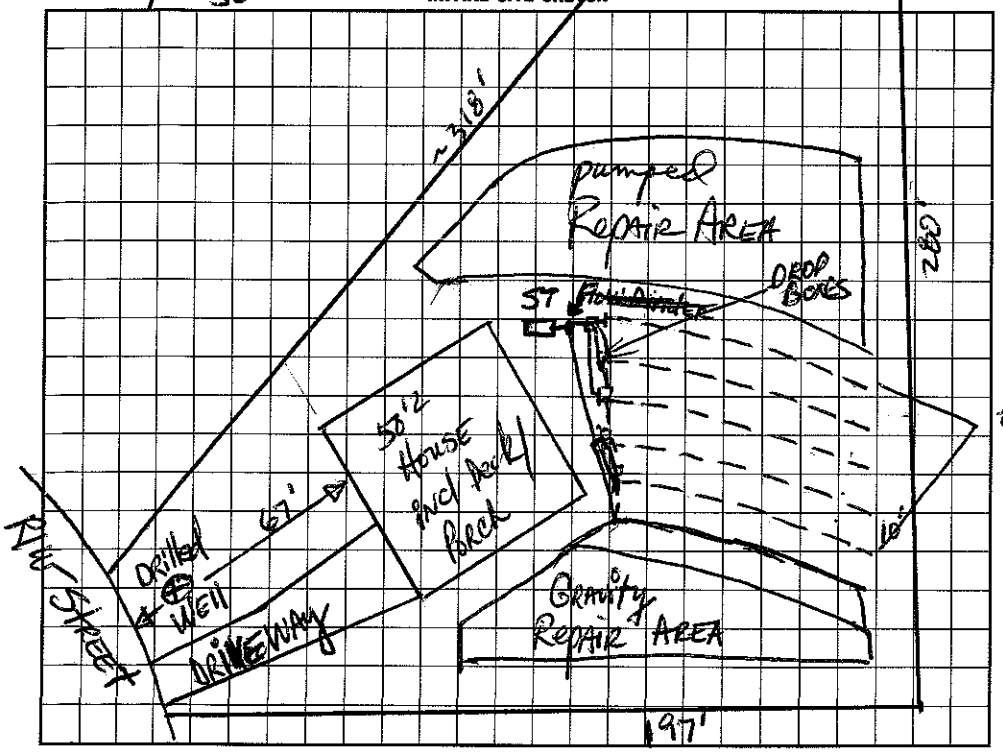

AS BUILT SKETCH

I understand that this permit can be suspended or revoked if any false information is supplied toward securing the permit/any unauthorized changes are made to the site/any unauthorized changes are made in the installation of the system. Improvement Permit with plat valid without expiration. Improvement Permit with site plan valid for sixty months. Authorization to Construct is valid for a period equal to that of Improvement Permit – not to exceed sixty months.

Signed: date 6-18-98

Improvement Permit by: date 6-10-98

Authorization to Construct by: date 6-18-98

Installed by: Rowan Septic

Operation Permit by: EHS date 1/21/99

Existing System Inspection by: date

HEALTH DEPT. COPY: WHITE INSPECTION COPY (FINAL): GREEN OWNER COPY (FINAL): YELLOW INSPECTION COPY (INITIAL): PINK OWNER COPY (INITIAL): GOLD